

STATE ENGINEER
Salem, Oregon

UMAT
4264

Well Record

STATE WELL NO. 6N/35-16N(2)
COUNTY Umatilla
APPLICATION NO. _____

OWNER: F. E. Kralman

MAILING ADDRESS: _____

LOCATION OF WELL: Owner's No. _____


CITY AND STATE: _____

SW $\frac{1}{4}$ SW $\frac{1}{4}$ Sec. 16 T. 6 ~~N.~~ S. R. 35 ~~E.~~ W., W.M.

Bearing and distance from section or subdivision corner _____

Altitude at well 750'

TYPE OF WELL: Drilled Date Constructed 1945
Depth drilled 46' Depth cased 43'

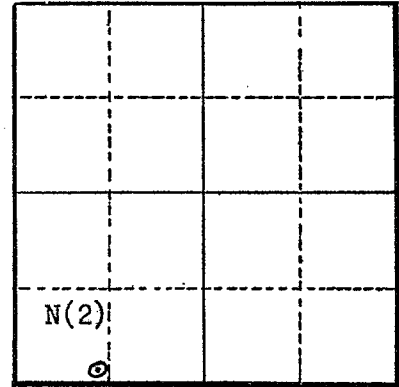

CASING RECORD:
8 inch

FINISH: Perforated 12 to 22 feet & 32 to 43 feet

AQUIFERS:
Gravel

WATER LEVEL:
7.4 feet (11/7/47)

PUMPING EQUIPMENT: Type Centrifugal H.P. _____
Capacity 130 G.P.M.

WELL TESTS:
Drawdown _____ ft. after _____ hours _____ G.P.M.
Drawdown _____ ft. after _____ hours _____ G.P.M.

USE OF WATER Irrigation Temp. _____ °F. _____, 19_____

SOURCE OF INFORMATION USGS

DRILLER or DIGGER A. A. Durand & Son

ADDITIONAL DATA:
Log X Water Level Measurements _____ Chemical Analysis _____ Aquifer Test _____

REMARKS:
Soil 0 to 8
Gravel & boulders 8 to 16
Gravel, loose 16 to 33
Gravel, cemented 33 to 44
Gravel, water bearing 44 to 46