

STATE ENGINEER  
Salem, Oregon

UMAT  
4265

# Well Record

STATE WELL NO. 6N/35-16K2  
COUNTY UMATILLA  
APPLICATION NO. ....

OWNER: J. B. Rencken


MAILING  
ADDRESS: .....

LOCATION OF WELL: Owner's No. ....

CITY AND  
STATE: .....

..... 1/4 ..... 1/4 Sec. .... T. .... N. E.  
S., R. .... W., W.M.

Bearing and distance from section or subdivision  
corner .....

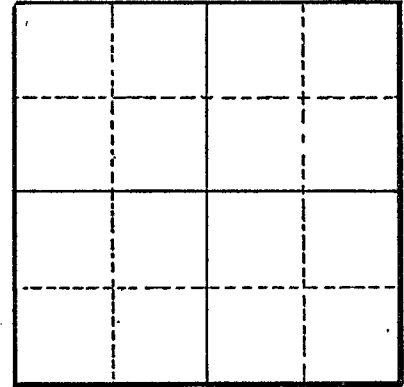

Section .....

Altitude at well 745

TYPE OF WELL: Dug Date Constructed .....

Depth drilled 24 Depth cased .....

### CASING RECORD:

60 inch

### FINISH:

### AQUIFERS:

Gravel from 10 to 24

### WATER LEVEL:

10-17 feet below land surface, 1947

PUMPING EQUIPMENT: Type Centrifugal H.P. ....  
Capacity 300 G.P.M.

### WELL TESTS:

Drawdown ..... ft. after ..... hours ..... G.P.M.  
Drawdown ..... ft. after ..... hours ..... G.P.M.

USE OF WATER Irrigation Temp. °F. ...., 19.....

SOURCE OF INFORMATION USGS

DRILLER or DIGGER .....

### ADDITIONAL DATA:

Log ..... Water Level Measurements ..... Chemical Analysis ..... Aquifer Test .....

### REMARKS: