

STATE ENGINEER  
Salem, Oregon

UMAT  
4315

# Well Record

STATE WELL NO. 6N/35-19R(2)  
COUNTY Umatilla  
APPLICATION NO. GR- 906

OWNER: J. E. Myers


MAILING ADDRESS: Rt. 2 Box 166A

LOCATION OF WELL: Owner's No.

CITY AND STATE: Milton-Freewater, Oregon

SE 1/4 SE 1/4 Sec. 19 T. 6 N. 35 E. W.M.

Bearing and distance from section or subdivision corner 708' N. & 50' W. of SE cor. sec. 19

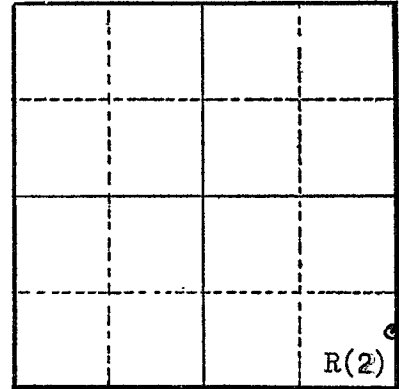

Altitude at well 650'

TYPE OF WELL: Dug Date Constructed Apr. 1920

Depth drilled 25' Depth cased

Section 19

### CASING RECORD:

72 inch diameter with 6" concrete liner (poured) from 0 to 20 feet

### FINISH:

### AQUIFERS:

Gravel from 19 to 25 feet

### WATER LEVEL:

6 feet

PUMPING EQUIPMENT: Type Pacific centrifugal 3"x4" H.P. 3  
Capacity 500 G.P.M.

### WELL TESTS:

Drawdown 10 ft. after hours 500 G.P.M.  
Drawdown ft. after hours G.P.M.

USE OF WATER Irrigation Temp. °F. 19

SOURCE OF INFORMATION GR- 880

DRILLER or DIGGER

### ADDITIONAL DATA:

Log  Water Level Measurements Chemical Analysis Aquifer Test

### REMARKS:

Silt loam 0 to 6  
Gravel 6 to 25