

STATE ENGINEER
Salem, Oregon

UMAT
4354

Well Record

STATE WELL NO. 6N/35-21G(1)
COUNTY Umatilla
APPLICATION NO. GR-1196

GR- 1157

OWNER: George Haasch


MAILING ADDRESS: Rt. 2, Box 253

LOCATION OF WELL: Owner's No.

CITY AND STATE: Milton-Freewater, Oregon

SW 1/4 NE 1/4 Sec. 21 T. 6 N. R. 35 E. W.M.

Bearing and distance from section or subdivision
corner 30' W. of SE cor. of SW 1/4 of Sec. 21.

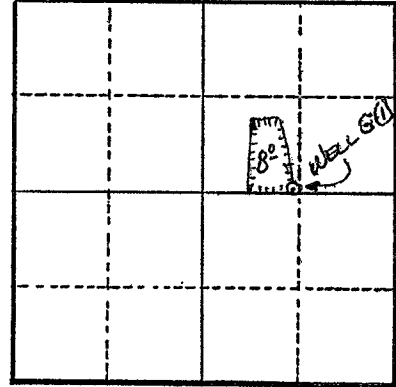

Section 21

Altitude at well 740 ft.

TYPE OF WELL: Dug&Drilled Date Constructed 1924

Depth drilled 95 ft. Depth cased

CASING RECORD:

Dug for 30 ft. (4 1/2 x 4 1/2 ft.)
Drilled from 30 to 95 ft. (6 in.)

FINISH:

AQUIFERS:

WATER LEVEL:

18 ft.

PUMPING EQUIPMENT: Type Peerless 3 in. turbine H.P. 3
Capacity 120 G.P.M.

WELL TESTS:

Drawdown 75 ft. after hours 120 G.P.M.

Drawdown ft. after hours G.P.M.

USE OF WATER Irrigation Temp. °F., 19

SOURCE OF INFORMATION G. R. Record

DRILLER or DIGGER Ted VanVorst

ADDITIONAL DATA:

Log N. A. Water Level Measurements Chemical Analysis Aquifer Test

REMARKS:

Irrigation of 8 acres.