

STATE ENGINEER
Salem, Oregon

UMAT
4355

Well Record

STATE WELL NO. 6N/35-21
COUNTY Umatilla
APPLICATION NO. GR-2253

OWNER: Wm. Bade


MAILING ADDRESS:

LOCATION OF WELL: Owner's No.

CITY AND STATE: Milton-Freewater, Oregon

NE 1/4 NW 1/4 Sec. 21 T. 6 N. S., R. 35 E., W.M.

Bearing and distance from section or subdivision corner

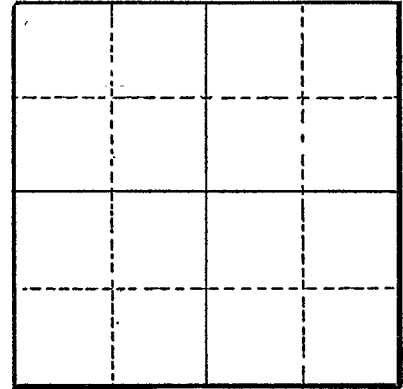

Section 21

Altitude at well

TYPE OF WELL: Dug Date Constructed 1924

Depth drilled 33 Depth cased

CASING RECORD:

Unknown

FINISH:

Unknown

AQUIFERS:

Unknown

WATER LEVEL:

Unknown

PUMPING EQUIPMENT: Type Peerless turbine 4 inch 3 phase H.P. 5
Capacity 125 G.P.M.

WELL TESTS:

Drawdown ft. after hours G.P.M.

Drawdown ft. after hours G.P.M.

USE OF WATER Irrigation Temp. °F., 19

SOURCE OF INFORMATION GR-2253

DRILLER or DIGGER

ADDITIONAL DATA:

Log Water Level Measurements Chemical Analysis Aquifer Test

REMARKS: