

STATE ENGINEER  
Salem, Oregon

UMAT  
4356

# Well Record

STATE WELL NO. 6N/35-21G(2)  
COUNTY Umatilla  
APPLICATION NO. GR-1131

GR- 1091

OWNER: William G. Bade

MAILING  
ADDRESS:


LOCATION OF WELL: Owner's No. #1

CITY AND  
STATE: Milton-Freewater, Oregon

NE 1/4 NW 1/4 Sec. 21 T. 6 N. R. 35 E., W.M.

Bearing and distance from section or subdivision

corner 150' W. & 450' S. from NE 1/4 cor. Sec. 21.

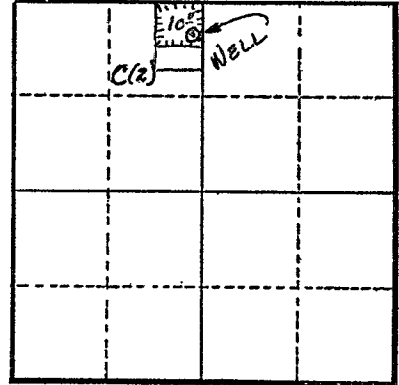

Section 21

Altitude at well 1200 ft.

TYPE OF WELL: Dug Date Constructed 1913

Depth drilled 30 ft. Depth cased

### CASING RECORD:

72" x 72" ???

### FINISH:

### AQUIFERS:

### WATER LEVEL:

20 ft.

PUMPING EQUIPMENT: Type 4 in. Johnston turbine H.P. 3

Capacity 200 G.P.M.

### WELL TESTS:

Drawdown 8 ft. after 200 hours G.P.M.

Drawdown ft. after hours G.P.M.

USE OF WATER Irrigation Temp. °F., 19

SOURCE OF INFORMATION G. R. Record

DRILLER or DIGGER

### ADDITIONAL DATA:

Log N.A. Water Level Measurements Chemical Analysis Aquifer Test

### REMARKS:

Irrigation of 10 acres.