

STATE ENGINEER
Salem, Oregon

UMAT
4384

Well Record

GR- 1105

STATE WELL NO. 6N/35-22N(1)
COUNTY Umatilla
APPLICATION NO. GR- 1145

OWNER: Cecil I. Strong

MAILING ADDRESS: Rt. 3, Box 43


LOCATION OF WELL: Owner's No. _____

CITY AND STATE: Milton-Freewater, Oregon

SW $\frac{1}{4}$ SW $\frac{1}{4}$ Sec. 22 T. 6 N. W. E. W.M.
R. 35

Bearing and distance from section or subdivision

corner 15' N. & 60' W. of SE cor. Sec. 22.

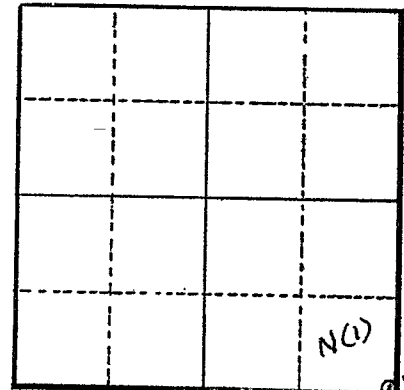

Section 22

Altitude at well 800 ft.

TYPE OF WELL: Dug Date Constructed 1926

Depth drilled 14 ft. Depth cased 7 ft.

CASING RECORD:

60 in. from 0 to 7 ft.

FINISH:

AQUIFERS:

WATER LEVEL:

7 ft.

PUMPING EQUIPMENT: Type Byron-Jackson 2 1/2" Cent. H.P. 5
Capacity _____ G.P.M.

WELL TESTS:

Drawdown 5 ft. after _____ hours 200 G.P.M.

Drawdown _____ ft. after _____ hours _____ G.P.M.

USE OF WATER Irrigation Temp. _____ °F. _____, 19____

SOURCE OF INFORMATION G. R. Record

DRILLER or DIGGER _____

ADDITIONAL DATA:

Log _____ Water Level Measurements _____ Chemical Analysis _____ Aquifer Test _____

REMARKS:

Log: Top soil 0 to 2 ft.
Clay 2 to 8 ft.
Gravel & rock 8 to 14 ft.

Irrigation of 9 1/4 acres.