

STATE ENGINEER  
Salem, Oregon

UMAT  
4385

UMAT 4385  
Well Record

GR- 1678

STATE WELL NO. 6N/35-22E  
COUNTY Umatilla  
APPLICATION NO. GR- 1720

OWNER: Frank J. Parent

MAILING

ADDRESS: Rt. 2, Box 239

LOCATION OF WELL: Owner's No.


CITY AND

STATE: Milton-Freewater, Oregon

SE 1/4 SE 1/4 Sec. 22 T. 6 N. R. 35 E. W.M.

Bearing and distance from section or subdivision

corner 440' N. & 12' W. from SE cor. Sec. 22

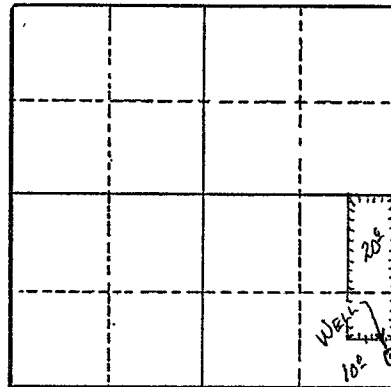

Section 22

Altitude at well 745'

TYPE OF WELL: Dug Date Constructed 1909

Depth drilled 18' Depth cased 12'

CASING RECORD:

6' wooden

FINISH:

AQUIFERS:

WATER LEVEL:

6'

PUMPING EQUIPMENT: Type Pump, Pipe & Power 1 1/2" x 1 1/4" H.P. 5  
Capacity 160 G.P.M.

WELL TESTS:

Drawdown ft. after hours G.P.M.

Drawdown ft. after hours G.P.M.

USE OF WATER Irrigation Temp. °F. 19

SOURCE OF INFORMATION GR Record

DRILLER or DIGGER

ADDITIONAL DATA:

Log Water Level Measurements Chemical Analysis Aquifer Test

REMARKS:

Log: Top soil 0 to 12 ft.  
Gravel 12 to 18 ft.

Irrigation of 30 acres.

WELL IDENTIFICATION FORM

Owner's Well Number: \_\_\_\_\_

CURRENT WELL OWNER:

Phone 360-895-4084

Name: STEVE PARANT (TRUSTEE) (HERBERT PARANT ESTATE) AND LARRY WIDNER

Mailing Address: P.O. Box 1222 c/o Bill Cole; Garton & Assoc. Realtors

City: PORT ORLAND Pendleton, OR 97801 State: WA. Zip: 97801

RECEIVED

WELL LOCATION:

UMAT 4385

JUN 1 1998

County: UMATILLA Latitude: \_\_\_\_\_ Longitude: \_\_\_\_\_ WATER RESOURCES DEPT SALEM, OREGON

Township: 6 (N) or S, Range: 35 E or W Section: 22 S.E. 1/4 S.W. 1/4

Tax Lot Number: 190, 1000

Street Address of Well (if different from above): WELL DIFFERED TO BY DEED

BOOK 93 PAGE 622

If a well report is available for this well, please attach a copy of it to this form and return. It is not necessary for you to complete the remainder of the form if the well report is attached. If a well report is not available, please complete the remainder of the form to the best of your ability.

WELL INFORMATION:

Start Card Number: \_\_\_\_\_ Approx. Construction Date: \_\_\_\_\_

Well Constructor: SE

Name of Owner at Time of Construction: BUYER: LARRY WIDNER  
(SELLER HERBERT PARANT ESTATE) JAMES BREEDING

Well Depth (in feet): \_\_\_\_\_ Static Water Level (in feet): \_\_\_\_\_

Diameter of Exposed Well Casing (in inches): \_\_\_\_\_

Does this well have a formal water right associated with it? Yes: \_\_\_\_\_ No: \_\_\_\_\_ If yes:

Application #: \_\_\_\_\_ Permit #: \_\_\_\_\_ Certificate #: \_\_\_\_\_

Please Return Completed Form to: Oregon Water Resources Department  
158 12th Street NE  
Salem, OR 97310

(Office use only)

26152

Well Identification Number: \_\_\_\_\_