

STATE ENGINEER  
Salem, Oregon

UMAT  
4452

# Well Record


STATE WELL NO. 6N/35-23R(A)  
COUNTY Umatilla  
APPLICATION NO. 1209

OWNER: James P. Seitz MAILING ADDRESS: 118 Newell Street

LOCATION OF WELL: Owner's No. \_\_\_\_\_ CITY AND STATE: Walla Walla Wash.

SE ¼ SE ¼ Sec. 23 T. 6 <sup>N</sup>/<sub>S</sub>, R. 35 <sup>E</sup>/<sub>W</sub>, W.M.

Bearing and distance from section or subdivision corner 666' W & 21' N from SE corner section 23

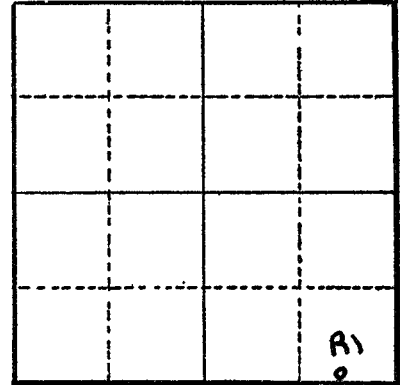

Section 23

Altitude at well \_\_\_\_\_

TYPE OF WELL: Drilled Date Constructed 1946

Depth drilled 196 Depth cased \_\_\_\_\_

CASING RECORD:  
8-inch

FINISH:

AQUIFERS:

WATER LEVEL:

8' below land surface, 1946

PUMPING EQUIPMENT: Type Cent. H.P. 5  
Capacity 220 G.P.M.

WELL TESTS:

Drawdown to 20 ft. after \_\_\_\_\_ hours 01 220 G.P.M.

Drawdown \_\_\_\_\_ ft. after \_\_\_\_\_ hours \_\_\_\_\_ G.P.M.

USE OF WATER Irrigation Temp. \_\_\_\_\_ °F. \_\_\_\_\_, 19\_\_\_\_

SOURCE OF INFORMATION U 209

DRILLER or DIGGER \_\_\_\_\_

ADDITIONAL DATA:

Log  Water Level Measurements \_\_\_\_\_ Chemical Analysis \_\_\_\_\_ Aquifer Test \_\_\_\_\_

REMARKS:

