

UMAT
4453

Well Record

STATE WELL NO. 6N/35-23H(1)
COUNTY Umatilla
APPLICATION NO. G- 1286

OWNER: Margaret Haun

MAILING ADDRESS:

Rt. 1 Box 344A


LOCATION OF WELL: Owner's No. _____

CITY AND STATE:

Walla Walla, Washington

SE $\frac{1}{4}$ NE $\frac{1}{4}$ Sec. 23 T. 6 ~~N.~~ R. 35 ~~E.~~ W., W.M.

Bearing and distance from section or subdivision corner 640'S. & 605'W. from SE cor. of NE $\frac{1}{4}$ NE $\frac{1}{4}$ of sec. 23

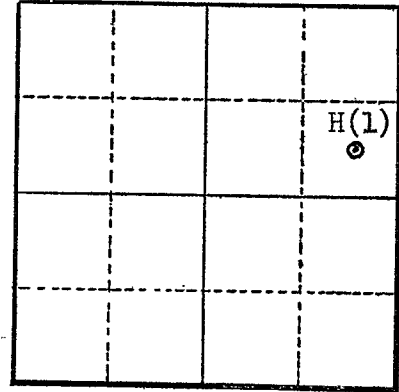

Section 23

Altitude at well _____

TYPE OF WELL: Drilled Date Constructed 1939

Depth drilled 38' Depth cased 20'

CASING RECORD:

8 inch

FINISH:

AQUIFERS:

WATER LEVEL:

3 feet

PUMPING EQUIPMENT: Type 2" centrifugal
Capacity _____ G.P.M.

H.P. 5

WELL TESTS:

Drawdown _____ ft. after _____ hours _____ G.P.M.

Drawdown _____ ft. after _____ hours _____ G.P.M.

USE OF WATER Irrigation Temp. _____ °F. _____, 19_____

SOURCE OF INFORMATION G- 1184

DRILLER or DIGGER _____

ADDITIONAL DATA:

Log NA Water Level Measurements _____ Chemical Analysis _____ Aquifer Test _____

REMARKS: