

STATE ENGINEER
Salem, Oregon

UMAT
4457

Well Record

STATE WELL NO. 6N/35-23Q(1)
COUNTY Umatilla
APPLICATION NO. U-45

OWNER: O. T. Hittle

MAILING ADDRESS:


LOCATION OF WELL: Owner's No. _____

CITY AND STATE:

Milton-Freewater, Oregon

SE 1/4 SE 1/4 Sec. 23 T. 6 ^{N.}~~XX~~, R. 35 ^{E.}~~XX~~, W.M.

Bearing and distance from section or subdivision corner 200' N. & 35' W. of SE cor. of SW 1/4 SE 1/4 of sec. 23.

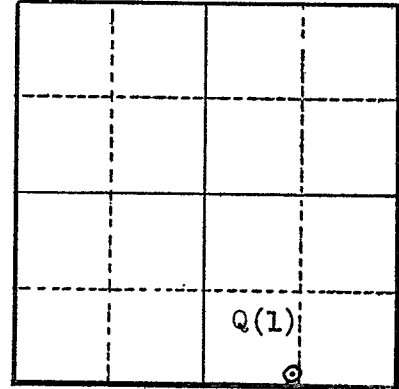

Section 23

Altitude at well _____

TYPE OF WELL: Dug&Drilled Date Constructed 1931

Depth drilled 25' Depth cased _____

CASING RECORD:

60" diam. to 18 ft.
8" to 95 ft.

FINISH: _____

AQUIFERS: _____

WATER LEVEL:

8 feet in Jan. 1931

PUMPING EQUIPMENT: Type _____ H.P. _____
Capacity 125 G.P.M.

WELL TESTS:

Drawdown _____ ft. after _____ hours _____ G.P.M.
Drawdown _____ ft. after _____ hours _____ G.P.M.

USE OF WATER Irrigation Temp. _____ °F. _____, 19____

SOURCE OF INFORMATION U-40

DRILLER or DIGGER _____

ADDITIONAL DATA:

Log Water Level Measurements _____ Chemical Analysis _____ Aquifer Test _____

REMARKS:

Soil	0 to 7
Sand, white	7 to 12
Clay	12 to 18
Gravel & conglomerate	18 to 34
Quicksand	34 to 49