

STATE ENGINEER
Salem, Oregon

UMAT
4458

Well Record

GR- 1245


STATE WELL NO. 6N/35-23L(3)
COUNTY Umatilla
APPLICATION NO. GR- 1288

OWNER: Levene W. Braun MAILING ADDRESS: Rt. 3, Box 182

LOCATION OF WELL: Owner's No. _____ CITY AND STATE: Milton-Freswater, Oregon

NE ¼ SW ¼ Sec. 23 T. 6 N. W, R. 35 W, W.M.

Bearing and distance from section or subdivision corner 1810' N. & 754' W. from S¼ cor. Sec. 23.

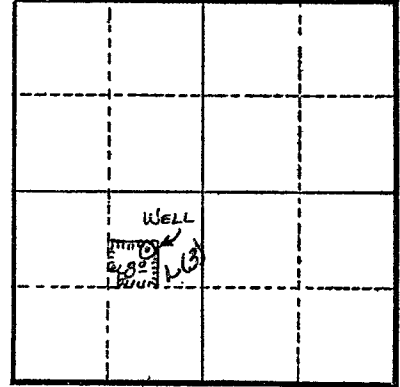

Section _____

Altitude at well 875 ft.

TYPE OF WELL: Drilled Date Constructed 1920

Depth drilled 24.5 ft. Depth cased _____

CASING RECORD:

8 inch

FINISH:

AQUIFERS:

WATER LEVEL:

4 ft.

PUMPING EQUIPMENT: Type F. M. Pomona turbine H.P. 1½
Capacity _____ G.P.M.

WELL TESTS:

Drawdown _____ ft. after _____ hours _____ G.P.M.

Drawdown _____ ft. after _____ hours _____ G.P.M.

USE OF WATER Irrigation Temp. _____ °F., 19 _____

SOURCE OF INFORMATION G. R. Record

DRILLER or DIGGER _____

ADDITIONAL DATA:

Log N.A. Water Level Measurements _____ Chemical Analysis _____ Aquifer Test _____

REMARKS:

Irrigation of 8 acres.