

(1) OWNER: STATE ENGINEER
Name Fred MOORE OREGON
Address 229 Eagan Walla Walla, Washington

(11) SWELL TESTS: Drawdown is amount water level is lowered below static level
Was a pump test made? Yes No If yes, by whom?
Yield: gal./min. with ft. drawdown after hrs.
" " " " "
" " " " "
Bailer test 75 gal./min. with None ft. drawdown after 2 hrs.
Artesian flow g.p.m. Date
Temperature of water Was a chemical analysis made? Yes No

(2) LOCATION OF WELL:
County UMATILLA Owner's number, if any—
1/4 1/4 Section T. R. W.M.
Bearing and distance from section or subdivision corner
see enclosure

(12) WELL LOG: Diameter of well 6 inches.
Depth drilled 63 ft. Depth of completed well 63 ft.
Formation: Describe by color, character, size of material and structure, and show thickness of aquifers and the kind and nature of the material in each stratum penetrated, with at least one entry for each change of formation.

| MATERIAL | FROM | TO |
|--------------------------------|------|----|
| Top Soil | 8 | 8 |
| Clay-like Brownish-yellow soil | 34 | 42 |
| Gravel clay (Little water) | 2 | 44 |
| Gravel | 1 | 45 |
| Cement Gravel | 8 | 53 |
| Gravel | 4 | 57 |
| Loose Gravel (Water) | 6 | 63 |

(3) TYPE OF WORK (check):
New Well Deepening Reconditioning Abandon
If abandonment, describe material and procedure in Item 11.

(4) PROPOSED USE (check):
Domestic Industrial Municipal
Irrigation Test Well Other
(5) TYPE OF WELL:
Rotary Driven
Cable Jetted
Dug Bored

(6) CASING INSTALLED: Threaded Welded
6" Diam. from 0 ft. to 63 ft. Gage 1/4"

(7) PERFORATIONS: Perforated? Yes No
Type of perforator used
SIZE of perforations in. by in.
perforations from ft. to ft.
perforations from ft. to ft.
perforations from ft. to ft.
perforations from ft. to ft.
perforations from ft. to ft.

(8) SCREENS: Well screen installed Yes No
Manufacturer's Name
Type Model No.
Diam. Slot size Set from ft. to ft.
Slot size Set from ft. to ft.

(9) CONSTRUCTION:
Was well gravel packed? Yes No Size of gravel:
Gravel placed from ft. to ft.
Was a surface seal provided? Yes No To what depth? 18 ft.
Material used in seal— Cement
Did any strata contain unusable water? Yes No
Type of water? Depth of strata
Method of sealing strata off

(10) WATER LEVELS:
Static level 30 ft. below land surface Date 6/17/65
Artesian pressure lbs. per square inch Date

Log Accepted by:
[Signed] Frederick H. Moore Date 11 JAN, 1966 (Owner)
Bernice J. Moore
(USE ADDITIONAL SHEETS IF NECESSARY)


(13) PUMP:
Manufacturer's Name
Type: H.P.

Well Driller's Statement:
This well was drilled under my jurisdiction and this report is true to the best of my knowledge and belief.
NAME Moore & Anderson (Person, firm, or corporation) (Type or print)
Address P.O. Box 1228, Walla Walla, Wash.
Driller's well number
[Signed] (Well Driller)
License No. 205 Date 6-24, 1965

RECEIVED
JAN 13 1966
STATE ENGINEER
SALEM OREGON

OREGON TITLE COMPANY
OF PENDLETON
7 S. E. COURT AVE. - 276-2511
PENDLETON, OREGON

This plat is made solely for the purpose of assisting in locating the premises and the corners as shown on the plat, for variations, if any, in dimensions and location ascertained by actual survey.
INDEX No. 952cy

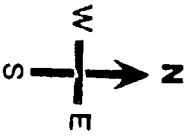


See Map 6N 35 24B

ROAD

1/4 Cor.

201
27 AC

200
28 05 AC

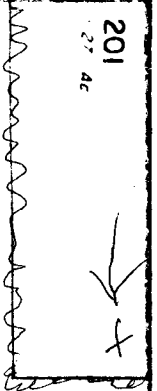

WELL

80 415 M.L. = 41.0

RIVER

100
80 00

The Northerly 170 feet of
the northwest quarter of the
northeast quarter of Section
24, township 6 North, Range
35.

The well is located inside the
northern line at the top of
a 30 foot embankment.

We first purchased the land
shown lined out but later
purchased the strip as shown
to the river.

400

4