

STATE ENGINEER  
Salem, Oregon

UMAT  
4506

# Well Record

STATE WELL NO. 6N/35-24D(1)  
COUNTY Umatilla  
APPLICATION NO. U-605

OWNER: E. F. Arnold

MAILING ADDRESS: Milton-Freewater, Oregon


LOCATION OF WELL: Owner's No. 1

CITY AND STATE:

NW 1/4 NW 1/4 Sec. 24 T. 6 N. S, R. 35 E. W, W.M.

Bearing and distance from section or subdivision corner 960 ft E and 530 ft S from

NW corner of Sec. 24, T. 6 N., R. 35 E., W.M.

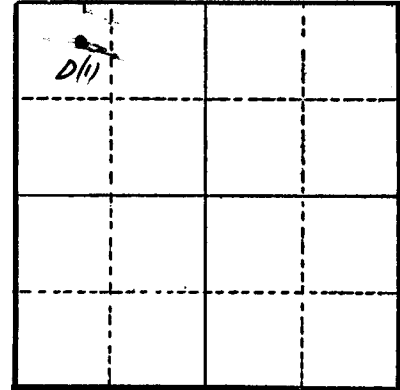

Section 24

Altitude at well

TYPE OF WELL: Drilled Date Constructed June 1953

Depth drilled 220 Depth cased

### CASING RECORD:

### FINISH:

### AQUIFERS:

### WATER LEVEL:

June 1953 34 ft;

PUMPING EQUIPMENT: Type Worthington turbine H.P. 15  
Capacity 200 G.P.M.

### WELL TESTS:

Drawdown 58 ft. after 1 1/2 hours 287 G.P.M.

Drawdown \_\_\_\_\_ ft. after \_\_\_\_\_ hours \_\_\_\_\_ G.P.M.

USE OF WATER Irrigation Temp. 55 °F. July 1953, 19\_\_

### SOURCE OF INFORMATION

DRILLER or DIGGER Geo. E. Scott, 141 S. Elizabeth, Milton-Freewater, Ore.

### ADDITIONAL DATA:

Log  Water Level Measurements \_\_\_\_\_ Chemical Analysis \_\_\_\_\_ Aquifer Test \_\_\_\_\_

### REMARKS:

