

UMAT
4507

Well Record

STATE WELL NO. 6N/35-24 F(1)
COUNTY UMATILLA
APPLICATION NO. 0218

OWNER: Andrew H Zessin

MAILING ADDRESS:


LOCATION OF WELL: Owner's No.

CITY AND STATE:

SE 1/4 NW 1/4 Sec. 24 T. 6 N. S, R. 35 W, W.M.

Bearing and distance from section or subdivision

corner 214' W. & 152' N from center section 24

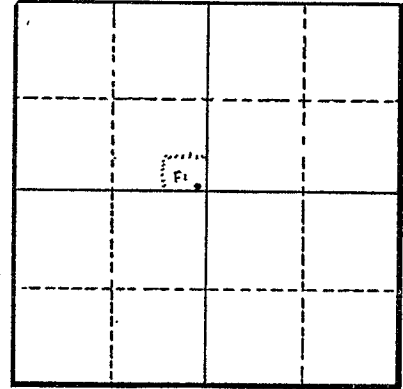

Section 24

Altitude at well

TYPE OF WELL: Drilled Date Constructed

Depth drilled 108 Depth cased

CASING RECORD:

8 inch

FINISH:

AQUIFERS:

WATER LEVEL:

20' below lsb

PUMPING EQUIPMENT: Type Jet

H.P. 3

Capacity 50 G.P.M.

WELL TESTS:

Drawdown ft. after hours G.P.M.

Drawdown ft. after hours G.P.M.

USE OF WATER Irrigation Temp. °F. 19

SOURCE OF INFORMATION

DRILLER or DIGGER

ADDITIONAL DATA:

Log Water Level Measurements Chemical Analysis Aquifer Test

REMARKS: well gradually filling up or caving, only 66' deep in 1956.