

UMAT
4514

Well Record

STATE WELL NO. 6N135 24
COUNTY CLATSOP
APPLICATION NO. GR-2099

OWNER: BLANCHE L. RANSOM


MAILING ADDRESS: Rt. 3 Box 227

LOCATION OF WELL: Owner's No. _____

CITY AND STATE: Milton - Free Water, Oregon

SX S1/4 SE 1/4 Sec. 24 T. 6 N. 8, R. 35 W., W.M.

Bearing and distance from section or subdivision corner 621' E + 30' N

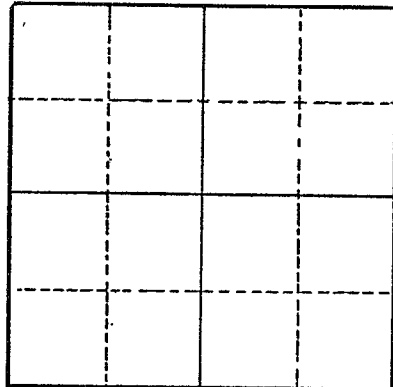

Section _____

Altitude at well _____

TYPE OF WELL: Dug & Drilled Date Constructed 1922

Depth drilled 55 Depth cased 15 37

CASING RECORD:

72 x 72
8-Inch

FINISH:

AQUIFERS:

Top Soil + gravel

WATER LEVEL:

PUMPING EQUIPMENT: Type Centrifugal pump H.P. 7 1/2
Capacity 300 G.P.M.

WELL TESTS:

Drawdown 6 ft. after _____ hours Pumping 420 G.P.M.
Drawdown _____ ft. after _____ hours _____ G.P.M.

USE OF WATER Irrigation Temp. _____ °F. _____, 19____

SOURCE OF INFORMATION GR-2016

DRILLER or DIGGER _____

ADDITIONAL DATA:

Log Water Level Measurements _____ Chemical Analysis _____ Aquifer Test _____

REMARKS:

Top Soil Gravelly + Gobbly 0 15
Cement gravel 15 55