

STATE ENGINEER
Salem, Oregon

UMAT
4556

Well Record

STATE WELL NO. 6N/35-25P(2)
COUNTY Umatilla
APPLICATION NO. GR-1177

GR- 1138

OWNER: Edwin F. Parent


MAILING ADDRESS: Rt. 3, Box 259

LOCATION OF WELL: Owner's No.

CITY AND STATE: Milton-Freewater, Oregon

SE 1/4 SW 1/4 Sec. 25 T. 6 N. R. 35 E. W.M.

Bearing and distance from section or subdivision corner 657' S. & 100' E. from the NW cor. of the SE 1/4 SW 1/4 of Sec. 25.

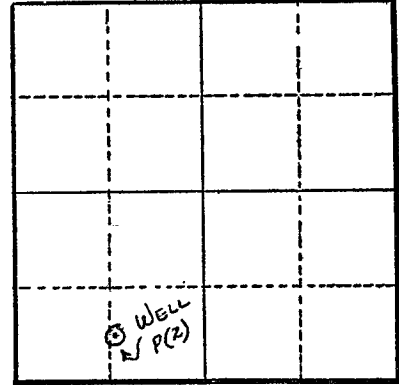

Section 25

Altitude at well 930 ft.

TYPE OF WELL: Dug & Drilled Date Constructed 1923

Depth drilled 78 ft. Depth cased 68 ft.

CASING RECORD:

8 in. from 36 to 68 ft.

FINISH:

Dug portion is 5 x 5 ft.
Drilled portion 8 in.

AQUIFERS:

WATER LEVEL:

Varies from 20 to 40 ft.

PUMPING EQUIPMENT: Type Pacific Highhead Pressure Pump H.P. 3
Capacity 132 G.P.M.

WELL TESTS:

Drawdown 20 to 40 ft. after hours 200 G.P.M.
Drawdown ft. after hours G.P.M.

USE OF WATER Dom. & Irrigation Temp. °F., 19

SOURCE OF INFORMATION G. R. Record

DRILLER or DIGGER

ADDITIONAL DATA:

Log N.A. Water Level Measurements Chemical Analysis Aquifer Test

REMARKS:

Irrigation of 7.98 acres.