

STATE ENGINEER
Salem, Oregon

UMAT
456

OBSERVATION WELL Well Record

STATE WELL NO. 2N/27-11N(1)
COUNTY Umatilla
APPLICATION NO. U-468
U-587

OWNER: O. D. McCarty


MAILING ADDRESS: _____

LOCATION OF WELL: Owner's No. _____

CITY AND STATE: Echo, Oregon

SW 1/4 SW 1/4 Sec. 11 T. 2 N. 27 E. W.M.

Bearing and distance from section or subdivision
corner N.18°40'E. 1373' from SW cor. of sec. 11

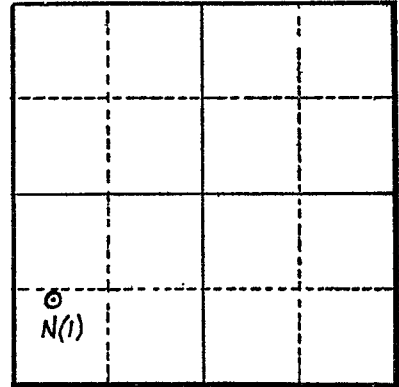

Section 11

Altitude at well _____

TYPE OF WELL: Drilled Date Constructed 1951

Depth drilled 280' Depth cased _____

CASING RECORD:
12 inch

FINISH: _____

AQUIFERS:
Basalt

WATER LEVEL:
45 feet (1/17/52)
88.6 feet (1/25/61) wsb

PUMPING EQUIPMENT: Type Turbine H.P. _____
Capacity _____ G.P.M.

WELL TESTS:
Drawdown 35 ft. after _____ hours 1150 to 1330 G.P.M.
Drawdown _____ ft. after _____ hours _____ G.P.M.

USE OF WATER Irrigation Temp. 62 °F. 1/17, 19.52

SOURCE OF INFORMATION U-425

DRILLER or DIGGER Ben Dreyer

ADDITIONAL DATA:
Log Water Level Measurements _____ Chemical Analysis _____ Aquifer Test _____

REMARKS:

Test by Parma Water Lifter Co., Parma Idaho - pumping from 70' at 1150 gpm
80' at 1330 gpm

