

STATE ENGINEER
Salem, Oregon

UMAT
4590

UMAT 4590
Well Record

STATE WELL NO. 6N/35-25B(1)
COUNTY UMATILLA
APPLICATION NO. _____

OWNER: D. GOODMAN


MAILING ADDRESS: _____

LOCATION OF WELL: Owner's No. _____

CITY AND STATE: _____

NW 1/4 NE 1/4 Sec. 25 T. 6 N. S. R. 35 E. W., W.M.

Bearing and distance from section or subdivision corner _____

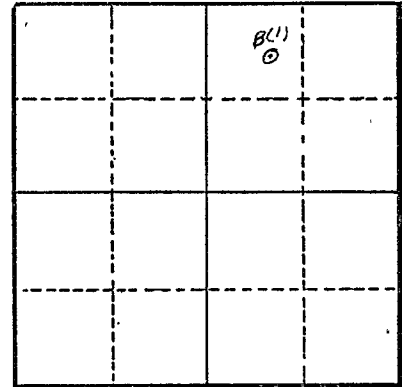

Section 25

Altitude at well 870'

TYPE OF WELL: Dr. & De. Date Constructed 1934

Depth drilled 402' Depth cased 54'

CASING RECORD:

60 - 8 INCH

FINISH:

AQUIFERS:

GRAVEL from 15 to 27

WATER LEVEL:

PUMPING EQUIPMENT: Type Centrifugal H.P. _____
Capacity 180 G.P.M.

WELL TESTS:

Drawdown _____ ft. after _____ hours _____ G.P.M.
Drawdown _____ ft. after _____ hours _____ G.P.M.

USE OF WATER IRR. Temp. _____ °F. _____, 19____

SOURCE OF INFORMATION U.S.G.S.

DRILLER or DIGGER SHORTRIDGE

ADDITIONAL DATA:

Log X Water Level Measurements _____ Chemical Analysis _____ Aquifer Test _____

REMARKS: SEE U.S.G.S. WALLA WALLA REPORT BY NEWCOMB (1951) PAGE 153

~~W/A~~ UMAT 4590

USGS Preliminary Report on the
Ground-water Resources of the Walla Walla Basin
Washington, Oregon

Page 153

R. C. Newcomb
1951

6/35-25B1. D. Goodman. Altitude about 870 feet. Drilled by
Shortridge, 1934

Recent alluvium and old gravels of Pleistocene age:		
Gravel, old dug well	27	27
Old clays of Pleistocene age:		
Clay, yellow	20	47
Clay, with gravel	43	90
Clay, blue, with some "boulders"	312	402
Casing, 8-inch, set 27-54 feet, open at bottom.		