

STATE ENGINEER
Salem, Oregon

UMAT
4599

Well Record

STATE WELL NO. 6N/35-25J
COUNTY Umatilla
APPLICATION NO. GR-1268


GR- 1224

OWNER: George L. Dugger
MAILING ADDRESS: Rt. 1, Box 131

LOCATION OF WELL: Owner's No. _____
CITY AND STATE: Milton-Freewater, Oregon

NE 1/4 SE 1/4 Sec. 25 T. 6 N. S., R. 35 E. W.M.

Bearing and distance from section or subdivision
corner 1325' N. & 655' W. from SE cor. Sec. 25.

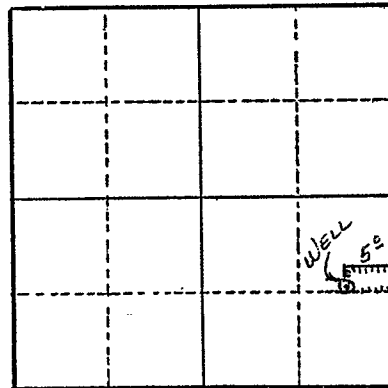

Section 25

Altitude at well 900 ft.

TYPE OF WELL: Dug Date Constructed 1926

Depth drilled 32 ft. Depth cased 12

CASING RECORD:

5 x 6 ft. concrete from 0 to 12 ft.

FINISH:

AQUIFERS:

WATER LEVEL:

6 ft.

PUMPING EQUIPMENT: Type DeLaval 1 1/2 in. H.P. 1
Capacity 96 G.P.M.

WELL TESTS:

Drawdown _____ ft. after _____ hours _____ G.P.M.
Drawdown _____ ft. after _____ hours _____ G.P.M.

USE OF WATER Irrigation Temp. _____ °F., 19

SOURCE OF INFORMATION G. R. Record

DRILLER or DIGGER _____

ADDITIONAL DATA:

Log _____ Water Level Measurements _____ Chemical Analysis _____ Aquifer Test _____

REMARKS:

Log: Top soil 0 to 6 ft.
Cement gravel 6 to 32 ft.

Irrigation of 5 acres.