

STATE ENGINEER
Salem, Oregon

UMAT
4601

Well Record

STATE WELL NO. 6N/35 - 25E
COUNTY UMATILLA
APPLICATION NO. GR-2098

OWNER: George Ransom


MAILING ADDRESS: Rt. 3, Box 227

LOCATION OF WELL: Owner's No. _____

CITY AND STATE: Milton-Freewater, Oregon

SW 1/4 NW 1/4 Sec. 25 T. 6N S., R. 35 E. W., W.M.

Bearing and distance from section or subdivision corner 232' E. & 13' N.

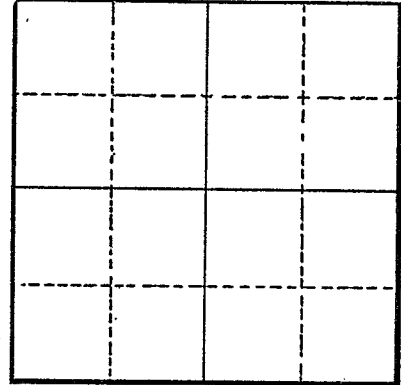

Section _____

Altitude at well _____

TYPE OF WELL: Dug & Drilled Constructed 1924
Depth drilled 64 Depth cased 16 38

CASING RECORD:

48 X 60 0 to 16
8-inch

FINISH:

AQUIFERS:

Top soil and gravel

WATER LEVEL:

16-feet

PUMPING EQUIPMENT: Type Centrifugal
Capacity 300 G.P.M.

H.P. 7 1/2

WELL TESTS:

Drawdown 5 ft. after _____ hours Pumping 420 G.P.M.
Drawdown _____ ft. after _____ hours _____ G.P.M.

USE OF WATER Irrigation Temp. _____ °F., 19

SOURCE OF INFORMATION GR-2015
DRILLER or DIGGER George Shortridge (Deceased)

ADDITIONAL DATA:

Log Water Level Measurements _____ Chemical Analysis _____ Aquifer Test _____

REMARKS:

Top soil & gravel 0 16
Cement gravel 16 64