

STATE ENGINEER
Salem, Oregon

UMAT
4602

Well Record

STATE WELL NO. 6N/35-25L
COUNTY Umatilla
APPLICATION NO. GR-3487

OWNER: Pioneer Posse


MAILING ADDRESS: 107 SE 3rd

LOCATION OF WELL: Owner's No.

CITY AND STATE: Milton-Freewater, Oregon

NE NE 1/4 SW 1/4 Sec. 25T. 6 N. S. R. 35 E. W.M.

Bearing and distance from section or subdivision corner 658' S. and 330' W.

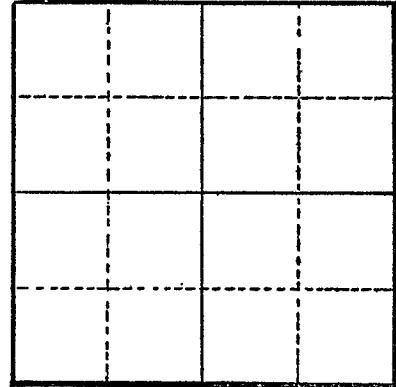

Section

Altitude at well

TYPE OF WELL: drilled dug & Date Constructed 1923

Depth drilled 50' Depth cased 12'

CASING RECORD:

72" and 6"

FINISH:

AQUIFERS:

WATER LEVEL:

15'

PUMPING EQUIPMENT: Type Couse - Crow Cent. H.P. 2
Capacity 150 G.P.M.

WELL TESTS:

Drawdown ft. after hours G.P.M.
Drawdown ft. after hours G.P.M.

USE OF WATER Irrigation Temp. °F., 19

SOURCE OF INFORMATION GR-3218

DRILLER or DIGGER Jim Overturf

ADDITIONAL DATA:

Log Water Level Measurements Chemical Analysis Aquifer Test

REMARKS: