

STATE ENGINEER  
Salem, Oregon

UMAT  
4604

# Well Record

GR- 1117

STATE WELL NO. 6N/35-25R(1)  
COUNTY Umatilla  
APPLICATION NO. GR- 1153

OWNER: Clay A. Grogan  
MAILING ADDRESS: Rt. 3, Box 376

LOCATION OF WELL: Owner's No. CITY AND STATE: Milton-Freewater, Oregon


SE 1/4 SE 1/4 Sec. 25 T. 6 N. R. 35 E. W.M.

Bearing and distance from section or subdivision  
corner 1020! N. & 400! W. from SE cor. Sec. 25.

Altitude at well 950 ft.

TYPE OF WELL: Dug & Drilled Date Constructed 1922

Depth drilled 101 ft. Depth cased 39 ft.

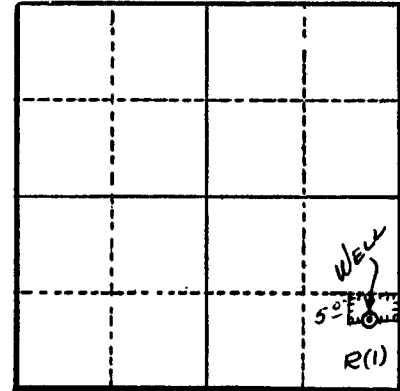

Section 25

### CASING RECORD:

60" x 60" concrete curb from 0 to 14 ft.  
6 in. from 19 to 39 ft.

### FINISH:

### AQUIFERS:

### WATER LEVEL:

PUMPING EQUIPMENT: Type 1 1/2" Cent. H.P. 1  
Capacity 150 G.P.M.

### WELL TESTS:

Drawdown 12 ft. after 150 hours G.P.M.  
Drawdown ft. after hours G.P.M.

USE OF WATER Irrigation Temp. °F. 19

SOURCE OF INFORMATION G. R. Record

DRILLER or DIGGER Earl Shortridge

### ADDITIONAL DATA:

Log Water Level Measurements Chemical Analysis Aquifer Test

### REMARKS:

Log: Top soil 0 to 3 ft.  
Sand 3 to 7 ft.  
Cement gravel 7 to 101 ft.

Irrigation of 5 acres.