

STATE ENGINEER
Salem, Oregon

UMAT
4605

Well Record

STATE WELL NO. 6N/35-25R
COUNTY UMATILLA
APPLICATION NO. GR-2809

OWNER: Mrs. Belle Poteest


MAILING ADDRESS: Box 130, Rt. 1

LOCATION OF WELL: Owner's No.

CITY AND STATE: Milton-Freewater, Oregon

SE 1/4 SE 1/4 Sec. 25 T. 6 N. 35 E. S. R. W. W.M.

Bearing and distance from section or subdivision corner 345' S. and 170' E.

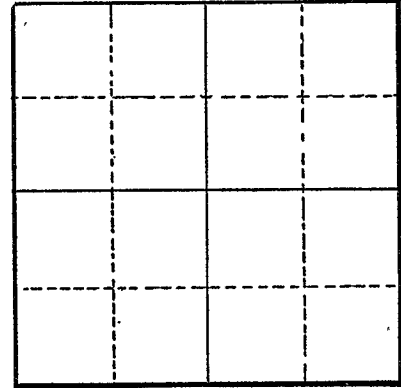

Section

Altitude at well

TYPE OF WELL: dug Date Constructed 1922

Depth drilled 27 Depth cased 7

CASING RECORD:

6' x 6'

FINISH:

AQUIFERS:

Gravel

WATER LEVEL:

12-feet

PUMPING EQUIPMENT: Type Centrifugal H.P. 1
Capacity 125 G.P.M.

WELL TESTS:

Drawdown ft. after hours G.P.M.
Drawdown ft. after hours G.P.M.

USE OF WATER irrigation Temp. °F., 19

SOURCE OF INFORMATION GR-2651

DRILLER or DIGGER

ADDITIONAL DATA:
Log Water Level Measurements Chemical Analysis Aquifer Test

REMARKS:

Gravel