

UMAT
4608

Well Record

OWNER: T. H. Halady


MAILING ADDRESS: Route 3

LOCATION OF WELL: Owner's No.

CITY AND STATE: Milton-Freewater, Oregon

NW 1/4 SE 1/4 Sec. 25 T. 6 N. R. 35 E. W.M.

Bearing and distance from section or subdivision
corner a point 710' N. from a point 430' E. from
SW cor. of Sec. 25

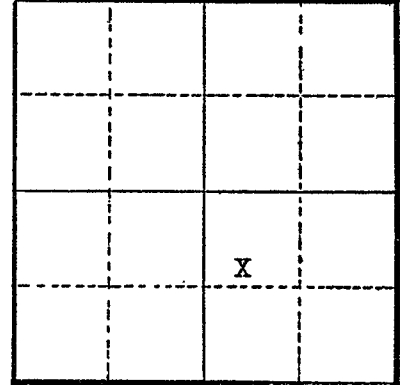

Section 25

Altitude at well

TYPE OF WELL: Drilled 46' Date Constructed 4/1/17

Depth drilled 68 feet Depth cased

CASING RECORD:

8 inch casing septh unknown

FINISH:

AQUIFERS:

WATER LEVEL:

varies from 10 to 20 feet

PUMPING EQUIPMENT: Type Pacific pump H.P. 3
Capacity 400 G.P.M.

WELL TESTS:

Drawdown ft. after hours G.P.M.
Drawdown ft. after hours G.P.M.

USE OF WATER Irrigation Temp. °F., 19

SOURCE OF INFORMATION Well Registration Statement Cert. # GR-3508

DRILLER or DIGGER

ADDITIONAL DATA:

Log X Water Level Measurements Chemical Analysis Aquifer Test

REMARKS:

Log: Top soil 6 to 8 ft. - gravel to bottom of well

RECEIVED
JUN 12 1956
STATE ENGINEER
SALEM, OREGON

Beginning at a point which is 155.0 feet North and 100.0 feet East of the intersection of the East right of-way line of the Oregon State Highway, and the East-West center line of Section 25, Township 6 North, Range 35, East of the Willamette Meridian, and run thence Northerly; parallel to said East right-of-way line, a distance of 516.92 feet, more or less, to a point in the South line of the County Road; thence Easterly, along the South line of the County Road, to the Northeast corner of the West one-half of the Southwest quarter of the Southeast quarter of the north-west quarter of said Section 25; thence Southerly, along the Easterly line of said West one-half of the Southwest quarter of the Southeast quarter of the Northwest quarter of 516.92 feet, more or less, to a point which is 155.0 feet North of said East-West center line of Section 25; thence Westerly, parallel to said East-West centerline to the point of beginning.