

STATE ENGINEER  
Salem, Oregon

UMAT  
4611

# Well Record

STATE WELL NO. 6N/35-25C  
COUNTY UMATILLA  
APPLICATION NO. GR-4066

OWNER: O. F. Hubbs


MAILING ADDRESS: Rt. 3 Box 237

LOCATION OF WELL: Owner's No. \_\_\_\_\_

CITY AND STATE: Milton, Oregon

NE 1/4 NW 1/4 Sec. 25 T. 6 N. R. 35 E., W.M.

Bearing and distance from section or subdivision corner 5' N & 280' E of the SW cor of NE 1/4 NW 1/4

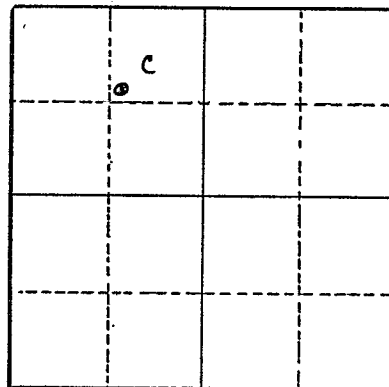

Section 25

Altitude at well \_\_\_\_\_

TYPE OF WELL: Drilled Date Constructed 1916

Depth drilled 306' Depth cased \_\_\_\_\_

### CASING RECORD:

8-inch

### FINISH:

### AQUIFERS:

### WATER LEVEL:

9'

PUMPING EQUIPMENT: Type Bean Deep Well H.P. 5  
Capacity 400 G.P.M.

### WELL TESTS:

Drawdown \_\_\_\_\_ ft. after \_\_\_\_\_ hours \_\_\_\_\_ G.P.M.

Drawdown \_\_\_\_\_ ft. after \_\_\_\_\_ hours \_\_\_\_\_ G.P.M.

USE OF WATER Irrigation Temp. \_\_\_\_\_ °F. \_\_\_\_\_, 19\_\_\_\_

SOURCE OF INFORMATION GR-3862

DRILLER or DIGGER NA

### ADDITIONAL DATA:

Log NA Water Level Measurements \_\_\_\_\_ Chemical Analysis \_\_\_\_\_ Aquifer Test \_\_\_\_\_

### REMARKS: