

STATE ENGINEER  
Salem, Oregon

UMAT  
4612

# Well Record

GR- 1103

STATE WELL NO. 6N/35-25L(2)  
COUNTY Umatilla  
APPLICATION NO. GR- 1143

OWNER: Loretta Stephens


MAILING ADDRESS: Rt. 3, Box 254

LOCATION OF WELL: Owner's No.

CITY AND STATE: Milton-Freewater, Oregon

NE 1/4 SW 1/4 Sec. 25 T. 6 N. R. 35 E., W.M.

Bearing and distance from section or subdivision corner 1460' E. & 1680' N. from SW cor. Sec. 25.

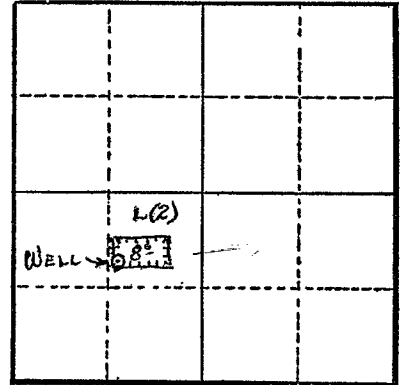

Section 25

Altitude at well 940 ft.

TYPE OF WELL: Dug & Drilled Date Constructed 1916

Depth drilled 61 ft. Depth cased 61 ft.

### CASING RECORD:

Dug ( 6' x 6' ) concrete curb from 0 to 40 ft.  
Drilled ( 6" ) steel casing from 40 to 61 ft.

### FINISH:

### AQUIFERS:

### WATER LEVEL:

12 ft.

PUMPING EQUIPMENT: Type 2" Cent. H.P. 3

Capacity 90 G.P.M.

### WELL TESTS:

Drawdown ft. after hours G.P.M.

Drawdown ft. after hours G.P.M.

USE OF WATER Irrigation Temp. °F. 19

SOURCE OF INFORMATION G. R. Record

DRILLER or DIGGER Earl Shortridge

### ADDITIONAL DATA:

Log N.A. Water Level Measurements Chemical Analysis Aquifer Test

### REMARKS:

Irrigation of 8 acres.