

STATE ENGINEER
Salem, Oregon

UMAT
4613

Well Record

GR- 1102

STATE WELL NO. 6N/35-25N(2)
COUNTY Umatilla
APPLICATION NO. GR- 1142

OWNER: Ruth Graham


MAILING ADDRESS: Rt. 1, Box 78

LOCATION OF WELL: Owner's No.

CITY AND STATE: Milton-Freewater, Oregon

SW 1/4 SW 1/4 Sec. 25 T. 6 N. R. 35 E., W.M.

Bearing and distance from section or subdivision corner 1330' S. & 75' W. from NE cor. NW 1/4 SW 1/4 of Section 25.

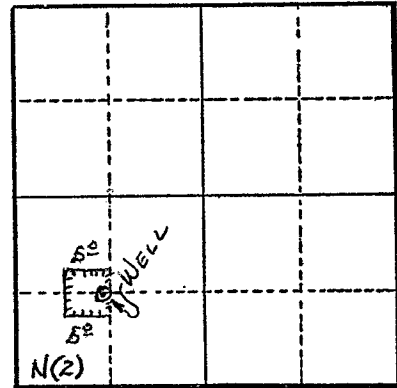

Section 25

Altitude at well

TYPE OF WELL: Dug & Drilled Date Constructed 1916

Depth drilled 90 ft. Depth cased

CASING RECORD:

Dug (6' x 8') from 0 to 49 ft.
Drilled (8 in.) from 49 to 90 ft.

FINISH:

AQUIFERS:

WATER LEVEL:

12 ft. (measured in April)

PUMPING EQUIPMENT: Type Cent. H.P. 5
Capacity 350 G.P.M.

WELL TESTS:

Drawdown ft. after hours G.P.M.
Drawdown ft. after hours G.P.M.

USE OF WATER Irrigation Temp. °F. 19

SOURCE OF INFORMATION G. R. Record

DRILLER or DIGGER

ADDITIONAL DATA:

Log N.A. Water Level Measurements Chemical Analysis Aquifer Test

REMARKS:

Irrigation of 10 acres.