

STATE ENGINEER
Salem, Oregon

UMAT
4664

Well Record

STATE WELL NO. 6N/35-25W(3)
COUNTY Umatilla
APPLICATION NO. GR-606

OWNER: Henry Williams & Ruby M. Shakelford


MAILING ADDRESS: Rt. 3 -

LOCATION OF WELL: Owner's No. 1

CITY AND STATE: Milton-Freewater, Oregon

SW 1/4 SW 1/4 Sec. 25 T. 6 N. S, R. 35 W., W.M.

Bearing and distance from section or subdivision corner 616 Ft. W. & 330 Ft. N. from S.E. cor. of SW 1/4 of S.W. 1/4 sec. 25

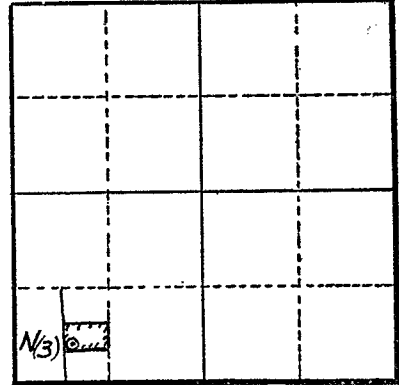

Section 25

Altitude at well 900 Ft. (approx.)

TYPE OF WELL: Drilled Date Constructed 1916

Depth drilled _____ Depth cased _____

CASING RECORD:

5' x 5' 38' deep
8 inch casing from 38ft.

FINISH:

AQUIFERS:

WATER LEVEL:

PUMPING EQUIPMENT: Type Centrifugal H.P. 3
Capacity 22.5 G.P.M.

WELL TESTS:

Drawdown _____ ft. after _____ hours _____ G.P.M.
Drawdown _____ ft. after _____ hours _____ G.P.M.

USE OF WATER irrigation - 5 Ac. Temp. _____ °F., 19____
SOURCE OF INFORMATION GR-606

DRILLER or DIGGER _____

ADDITIONAL DATA:

Log _____ Water Level Measurements _____ Chemical Analysis _____ Aquifer Test _____

REMARKS: