



# Well Record

STATE WELL NO. 6N/35-25F  
COUNTY Umatilla  
APPLICATION NO. GR-3575

OWNER: W. C. Mason


MAILING ADDRESS: Route 3, Box 275

LOCATION OF WELL: Owner's No. \_\_\_\_\_

CITY AND STATE: Milton-Freewater, Oregon

SE  $\frac{1}{4}$  NW  $\frac{1}{4}$  Sec. 25 T. 6 N. X, R. 35 W., W.M.

Bearing and distance from section or subdivision  
corner 613 ft. E. from a point 7 ft. N. from SW  
corner SE  $\frac{1}{4}$  of NW  $\frac{1}{4}$  Sec. 25

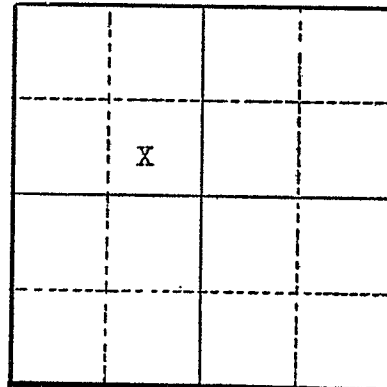

Section 25

Altitude at well \_\_\_\_\_

TYPE OF WELL: Drilled & Date Constructed 1915 & 1922

Dug  
Depth drilled 65 ft. Depth cased 42 ft.

### CASING RECORD:

6 inch casing set from 22 ft. to 42 ft.

Dug 22 ft. Feb., 1915  
Drilled 43 ft. June, 1922

### FINISH:

### AQUIFERS:

### WATER LEVEL:

PUMPING EQUIPMENT: Type 3 in. Krough pump centrifugal H.P. 5  
Capacity 300 G.P.M.

### WELL TESTS:

Drawdown 40 ft. after \_\_\_\_\_ hours 337 G.P.M.  
Drawdown \_\_\_\_\_ ft. after \_\_\_\_\_ hours \_\_\_\_\_ G.P.M.

USE OF WATER Irrigation Temp. \_\_\_\_\_ °F. \_\_\_\_\_, 19\_\_\_\_

SOURCE OF INFORMATION Well Registration Statement

DRILLER or DIGGER \_\_\_\_\_

### ADDITIONAL DATA:

Log X Water Level Measurements \_\_\_\_\_ Chemical Analysis \_\_\_\_\_ Aquifer Test \_\_\_\_\_

### REMARKS:

Log: Dug 22' - 6' top soil 16' - gravel  
drilled 45' thru gravel  
10' cement curving  
drill casing 20'