

STATE ENGINEER
Salem, Oregon

UMAT
4617

Well Record

STATE WELL NO. 6N/35-25P4
COUNTY Umatilla
APPLICATION NO. GR-392

Roy Hayden

OWNER: Harvey & Gladys Knifong &


MAILING ADDRESS: Rt. 3 Box 257

LOCATION OF WELL: Owner's No. _____

CITY AND STATE: Milton-Freewater, Ore.

SE 1/4 SW 1/4 Sec. 25 T. 6 N. R. 35 E., W.M.

Bearing and distance from section or subdivision corner 317.03 ft. S. from a point 76 ft. E. of the N.W. cor. of S.E. of SW

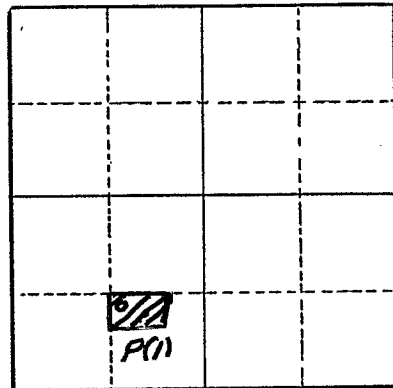

Section 25

Altitude at well _____

TYPE OF WELL: Dug-dug Date Constructed July 1915

Depth drilled 93 Depth cased _____

CASING RECORD:

6 inch

FINISH:

AQUIFERS:

WATER LEVEL:

16 to 46 feet

PUMPING EQUIPMENT: Type Cook Turbine H.P. 3
Capacity 75 G.P.M.

WELL TESTS:

Drawdown _____ ft. after _____ hours _____ G.P.M.
Drawdown _____ ft. after _____ hours _____ G.P.M.

USE OF WATER irrigation - 9.25 f domestic Temp. _____ °F., 19 _____

SOURCE OF INFORMATION GR-392

DRILLER or DIGGER Overturf & Cornellison

ADDITIONAL DATA:

Log No. Water Level Measurements _____ Chemical Analysis _____ Aquifer Test _____

REMARKS: