

STATE ENGINEER  
Salem, Oregon

UMAT  
4618

# Well Record


STATE WELL NO. 6N/35-250  
COUNTY UMATILLA  
APPLICATION NO. GR-2326

OWNER: Richard Steadman MAILING ADDRESS: Rt. 3, Box 243, Milton-Freewater

LOCATION OF WELL: Owner's No. CITY AND STATE: Milton-Freewater, Oregon

NE 1/4 NW 1/4 Sec. 25 T. 6 N. 8, R. 35 E. W.M.

Bearing and distance from section or subdivision corner 260' W. and 30' N.

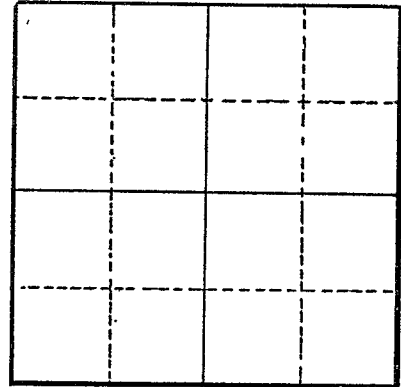

Section

Altitude at well

TYPE OF WELL: Dug Date Constructed 1915

Depth drilled 25 Depth cased 12 & 20

### CASING RECORD:

48 x 48-inch  
48-inch

### FINISH:

### AQUIFERS:

Top soil and gravel

### WATER LEVEL:

8-feet

PUMPING EQUIPMENT: Type Centrifugal 2 1/2" discharge H.P. 3  
Capacity 200 G.P.M.

### WELL TESTS:

Drawdown 1 1/2 ft. after hours Pumping 200 G.P.M.

Drawdown ft. after hours G.P.M.

USE OF WATER Irrigation Temp. °F. 19

SOURCE OF INFORMATION GR-2213

DRILLER or DIGGER

### ADDITIONAL DATA:

Log  Water Level Measurements  Chemical Analysis  Aquifer Test

### REMARKS:

Top soil 4 4  
Gravel 21 25