

STATE ENGINEER
Salem, Oregon

UMAT
4619

Well Record

STATE WELL NO. 6N/35-25
COUNTY Umatilla
APPLICATION NO. GR-3838

OWNER: Ben M. Johnson


MAILING ADDRESS: Rt. 1, Box 125

LOCATION OF WELL: Owner's No. _____

CITY AND STATE: Milton-Freewater, Oregon

1/4 1/4 Sec. 25 T. 6 ^{N.} S., R. 35 ^{E.} W., W.M.

Bearing and distance from section or subdivision
corner 507 feet N. & 999 feet E. of center
of Sec. 25

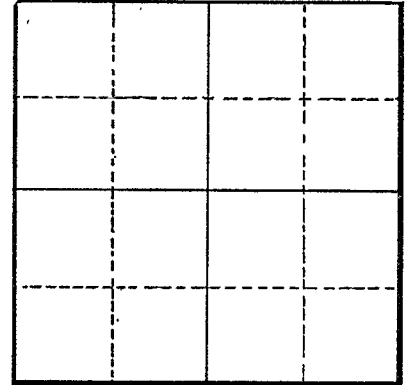

Section 25

Altitude at well _____

TYPE OF WELL: Drilled Date Constructed 1915

Depth drilled 78 Depth cased 46

CASING RECORD:

6 3/4" steel from 0 to 46 feet

FINISH:

Unknown

AQUIFERS:

Unknown

WATER LEVEL:

16 feet

PUMPING EQUIPMENT: Type 3/2" centrifugal Fairbanks Morse H.P. 7 1/2
Capacity 250 G.P.M. Elec.

WELL TESTS:

Drawdown _____ ft. after _____ hours _____ G.P.M.

Drawdown _____ ft. after _____ hours _____ G.P.M.

USE OF WATER Irrigation Temp. _____ °F. _____, 19____

SOURCE OF INFORMATION GR-3838

DRILLER or DIGGER _____

ADDITIONAL DATA:

Log _____ Water Level Measurements _____ Chemical Analysis _____ Aquifer Test _____

REMARKS:

