

STATE ENGINEER
Salem, Oregon

UMAT
4620

Well Record

STATE WELL NO. 6N/35-25L
COUNTY UMATILLA
APPLICATION NO. GR-2650

OWNER: Harold E. Akes


MAILING ADDRESS: Rt. 3, Box 253

LOCATION OF WELL: Owner's No.

CITY AND STATE: Milton-Freewater, Oregon

NE 1/4 SW 1/4 Sec. 25 T. 6 N. S. R. 35 E. W.M.

Bearing and distance from section or subdivision corner 325' W. thence 708' S.

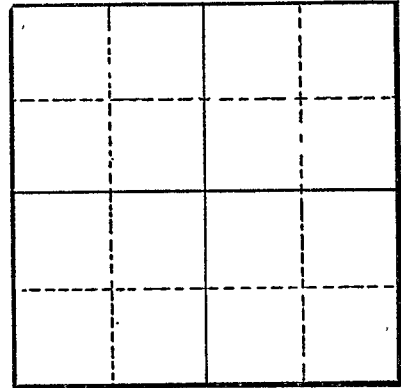

Section

Altitude at well

TYPE OF WELL Dug Drilled Date Constructed 1914

Depth drilled 65 Depth cased 65

CASING RECORD:

48-inch

FINISH:

AQUIFERS:

Dirt, rock, cavey and flour

WATER LEVEL:

24-feet

PUMPING EQUIPMENT: Type Fairbanks Morse Turbine H.P. 7 1/2
Capacity 300 G.P.M.

WELL TESTS:

Drawdown 1 ft. after hours pumping 200 G.P.M.
Drawdown ft. after hours G.P.M.

USE OF WATER Irrigation Temp. °F., 19

SOURCE OF INFORMATION GR-2512

DRILLER or DIGGER

ADDITIONAL DATA:

Log Water Level Measurements Chemical Analysis Aquifer Test

REMARKS:

Dirt 0 10
Concrete Rock 10 27
Cavey & flour 27 65
Some water all along - good flow from 60 to 65