

STATE ENGINEER
Salem, Oregon

UMAT
4621

Well Record

STATE WELL NO. 6N/35-25N
COUNTY UMATILLA
APPLICATION NO. GR-3494

OWNER: Artie W. and Opal P. Morris


MAILING ADDRESS: Rt 3 Box 265

LOCATION OF WELL: Owner's No.

CITY AND STATE: Milton Freewater, Oregon

SW 1/4 SW 1/4 Sec. 25 T. 6 N. R. 35 E., W.M.

Bearing and distance from section or subdivision corner 840' N and 90' E of SW corner of Sec 25

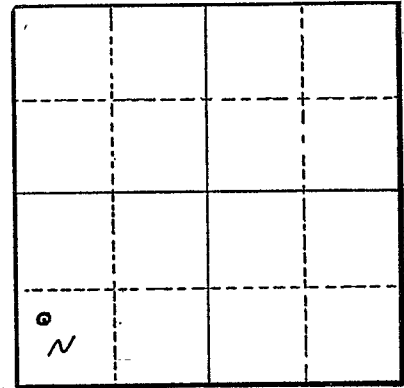

Section 25

Altitude at well

TYPE OF WELL: Dug/Drilled Date Constructed 1910

Depth drilled 72' Depth cased 50' to 72'

CASING RECORD:

6-inch	0' to 50'
8-inch	50' to 72'

FINISH:

AQUIFERS:

WATER LEVEL:

15' high
35' low

PUMPING EQUIPMENT: Type Centrifugal Pump H.P. 3
Capacity 175 G.P.M.

WELL TESTS:

Drawdown	ft. after	hours	300 +	G.P.M.
Drawdown	ft. after	hours		G.P.M.

USE OF WATER Irrigation Temp. °F., 19

SOURCE OF INFORMATION GR-3967

DRILLER or DIGGER

ADDITIONAL DATA:
Log NA Water Level Measurements Chemical Analysis Aquifer Test

REMARKS: