

STATE ENGINEER  
Salem, Oregon

UMAT  
4622

# Well Record


STATE WELL NO. 6N/35-25M  
COUNTY UMATILLA  
APPLICATION NO. GR-3495

OWNER: Artie W. and Opal P. Morris  
MAILING ADDRESS: Rt 3 Box 265

LOCATION OF WELL: Owner's No. \_\_\_\_\_  
CITY AND STATE: Milton Freewater, Oregon

N. E.  
NW 1/4 SW 1/4 Sec. 25 T. 6 S., R. 35 W.M.

Bearing and distance from section or subdivision  
corner 1333' N and 50' E of SW cor of Sec 25

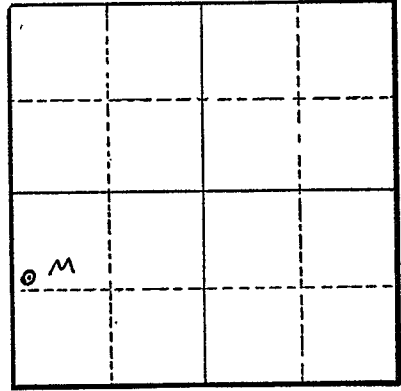

Section 25

Altitude at well \_\_\_\_\_

TYPE OF WELL: Dug Date Constructed 1910

Depth drilled 40' Depth cased 20'

### CASING RECORD:

6-inch concrete curb

### FINISH:

### AQUIFERS:

### WATER LEVEL:

15' high  
30' low

PUMPING EQUIPMENT: Type Centrifugal H.P. 3  
Capacity 175 G.P.M.

### WELL TESTS:

Drawdown \_\_\_\_\_ ft. after \_\_\_\_\_ hours 300 G.P.M.  
Drawdown \_\_\_\_\_ ft. after \_\_\_\_\_ hours \_\_\_\_\_ G.P.M.

USE OF WATER Irrigation Temp. \_\_\_\_\_ °F. \_\_\_\_\_, 19\_\_\_\_\_

SOURCE OF INFORMATION GR-3968

DRILLER or DIGGER \_\_\_\_\_

### ADDITIONAL DATA:

Log NA Water Level Measurements \_\_\_\_\_ Chemical Analysis \_\_\_\_\_ Aquifer Test \_\_\_\_\_

### REMARKS: