

STATE ENGINEER  
Salem, Oregon

UMAT  
4623

# Well Record

STATE WELL NO. 6N/35-25R  
COUNTY Umatilla  
~~APPLICATION NO. GR-3165~~

OWNER: Harold M. Stiller


MAILING ADDRESS: Route 1, Box 132

LOCATION OF WELL: Owner's No.

CITY AND STATE: Milton-Freewater, Oregon

S<sup>1</sup>/<sub>2</sub> SE 1/4 SE 1/4 Sec. 25 T. 6 N. 35 E. W.M.

Bearing and distance from section or subdivision corner 260' W. and 8' N.

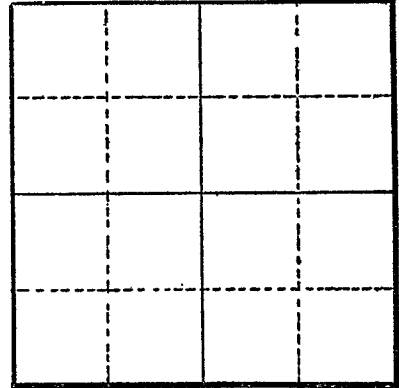

Section

Altitude at well

TYPE OF WELL: drilled Date Constructed 1907

Depth drilled 29' Depth cased 29'

CASING RECORD:

72" and 8"

FINISH:

AQUIFERS:

WATER LEVEL:

9'

PUMPING EQUIPMENT: Type Fairbanks Morse Cent. H.P. 7 1/2  
Capacity 225 G.P.M.

WELL TESTS:

Drawdown 17 ft. after hours pumping 100 G.P.M.  
Drawdown ft. after hours G.P.M.

USE OF WATER Irrigation Temp. °F., 19

SOURCE OF INFORMATION GR-3173

DRILLER or DIGGER Leo Counelisan

ADDITIONAL DATA:

Log Water Level Measurements Chemical Analysis Aquifer Test

REMARKS: