

STATE ENGINEER
Salem, Oregon

UMAT
4626

Well Record

STATE WELL NO. 6N/35-25-1
COUNTY UMATILLA
APPLICATION NO. 6525

OWNER: Homer C. & Bessie Hayes


MAILING ADDRESS: Rt 3, Box 250

LOCATION OF WELL: Owner's No. _____

CITY AND STATE: Milton Freewater

E
NW 1/4 SW 1/4 Sec. 25 T. 6 N. S. R. 35 W. W.M.

Bearing and distance from section or subdivision corner 50' S & 225' E from NW corner of NE 1/4 SW 1/4 Section 25

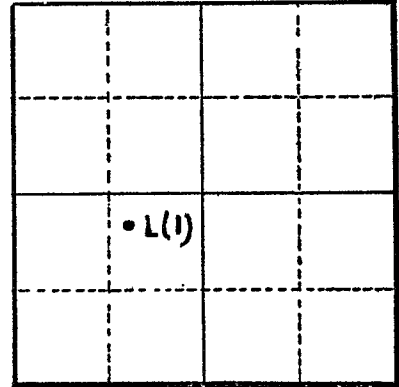

Section 25

Altitude at well _____

TYPE OF WELL: Drilled Date Constructed _____

Depth drilled 55 Depth cased 30

CASING RECORD:

8"

FINISH: _____

AQUIFERS: _____

WATER LEVEL:

20

PUMPING EQUIPMENT: Type J.T H.P. 3

Capacity _____ G.P.M.

WELL TESTS:

Drawdown _____ ft. after _____ hours _____ G.P.M.

Drawdown _____ ft. after _____ hours _____ G.P.M.

USE OF WATER Dom. 1.12 gal. Temp. _____ °F. _____, 19 _____

SOURCE OF INFORMATION 6525

DRILLER or DIGGER _____

ADDITIONAL DATA:

Log _____ Water Level Measurements _____ Chemical Analysis _____ Aquifer Test _____

REMARKS: _____