

STATE ENGINEER
Salem, Oregon

UMAT
467

Well Record


STATE WELL NO. 2N/27-34F
COUNTY Umatilla
APPLICATION NO. GR-4142

OWNER: B. P. Doherty
MAILING ADDRESS: 415 NW Furnish

LOCATION OF WELL: Owner's No. _____
CITY AND STATE: Pendleton, Oregon

SE 1/4 NW 1/4 Sec. 34 T. 2 N. R. 27 W., W.M.

Bearing and distance from section or subdivision
corner 1520 feet East and 220 feet North of Northwest
Corner, Northwest Quarter of the Southwest Quarter

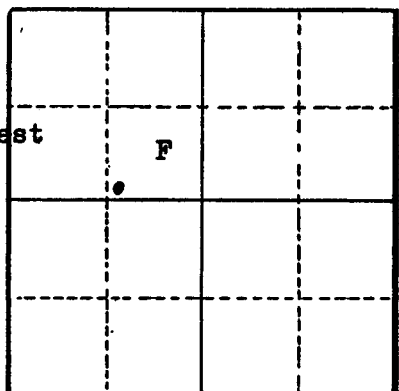

Section 34

Altitude at well 900 feet

TYPE OF WELL: Drilled Date Constructed 1925

Depth drilled 125 feet Depth cased 25 feet

CASING RECORD:

6-inch casing set from surface to 25 feet

FINISH:

AQUIFERS:

WATER LEVEL:

10 feet 13.51' below LSD (1/25/61) wsb

PUMPING EQUIPMENT: Type Surface, electrical centrifugal H.P. _____
Capacity 50 G.P.M.

WELL TESTS:

Drawdown none ft. after _____ hours 200 G.P.M.
Drawdown _____ ft. after _____ hours _____ G.P.M.

USE OF WATER Irrigation Temp. °F. _____, 19

SOURCE OF INFORMATION GR-4066, GR-4142

DRILLER or DIGGER _____

ADDITIONAL DATA:

Log (NA) Water Level Measurements _____ Chemical Analysis _____ Aquifer Test _____

REMARKS: