

STATE ENGINEER
Salem, Oregon


UMAT
4686

Well Record

STATE WELL NO. 6N/35-26J
COUNTY Umatilla
APPLICATION NO. GR-3840

OWNER: Aaron Weis MAILING ADDRESS: Route 3, Box
CITY AND STATE: Milton-Freewater, Oregon

LOCATION OF WELL: Owner's No. _____
NE 1/4 SE 1/4 Sec. 26 T. 6 N. 35 R. 35 E. W.M.
Bearing and distance from section or subdivision
corner 665' S. from a pt. 28' W. from SE cor.
of NE 1/4 of NE 1/4 Sec. 26

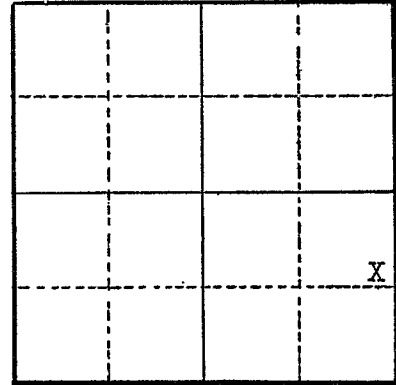

Section 26

Altitude at well _____

TYPE OF WELL: Dug Date Constructed 1927 prior to _____

Depth drilled 55 feet Depth cased _____

CASING RECORD:

FINISH:

AQUIFERS:

WATER LEVEL:

PUMPING EQUIPMENT: Type Pacific centrifugal H.P. 5
Capacity 500 G.P.M.

WELL TESTS:
Drawdown _____ ft. after _____ hours 500 G.P.M.
Drawdown _____ ft. after _____ hours _____ G.P.M.

USE OF WATER Irrigation Temp. _____ °F., 19 _____

SOURCE OF INFORMATION Well Registration Statement

DRILLER or DIGGER _____

ADDITIONAL DATA:

Log _____ Water Level Measurements _____ Chemical Analysis _____ Aquifer Test _____

REMARKS: