

STATE ENGINEER
Salem, Oregon

UMAT
4687

Well Record

STATE WELL NO. 6N/35-26N
COUNTY Umatilla
APPLICATION NO. GR-4069

OWNER: Aaron & Kathryn LeFore


MAILING ADDRESS: Route 3, Box 304

LOCATION OF WELL: Owner's No.

CITY AND STATE: Milton-Freewater, Oregon

SW 1/4 SW 1/4 Sec. 26 T. 6 N. S., R. 35 W., W.M.

Bearing and distance from section or subdivision corner 320' E. & 30' N. from SW Cor. Sec. 26

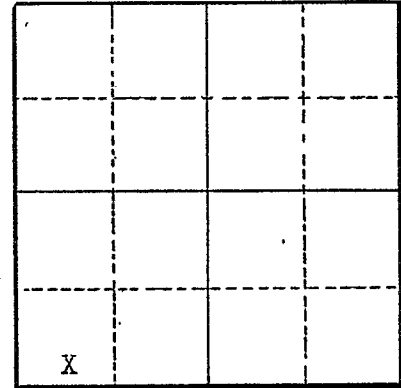

Section 26

Altitude at well

TYPE OF WELL: Dug 48' Drilled 50' Date Constructed 1927 prior

Depth drilled 98 ft. Depth cased

CASING RECORD:

72 in. concrete from 0 to 24 ft.
8 inch steel casing from 46' to unknown depth

FINISH:

AQUIFERS:

WATER LEVEL:

30 feet below surface

PUMPING EQUIPMENT: Type Turbine coop H.P. 3
Capacity 120 G.P.M.

WELL TESTS:

Drawdown ft. after hours G.P.M.
Drawdown ft. after hours G.P.M.

USE OF WATER Irrigation Temp. °F., 19

SOURCE OF INFORMATION Well Registration Statement Cert. # GR-3666

DRILLER or DIGGER

ADDITIONAL DATA:

Log Water Level Measurements Chemical Analysis Aquifer Test

REMARKS: