

STATE ENGINEER
Salem, Oregon

UMAT
4690

Well Record


STATE WELL NO. 6N/35-26F(1)
COUNTY Umatilla
APPLICATION NO. GR-1134

GR- 1094

OWNER: Carlton Otto; H.L. & Irene Warner & ADDRESS:
Melvin Nye. CITY AND STATE: Milton-Freewater, Oregon

LOCATION OF WELL: Owner's No.
SE 1/4 NW 1/4 Sec. 26 T. 6 N. R. 35 E., W.M.

Bearing and distance from section or subdivision
corner 660' N. & 1750' E. from W¹/₄ cor. Sec. 26.

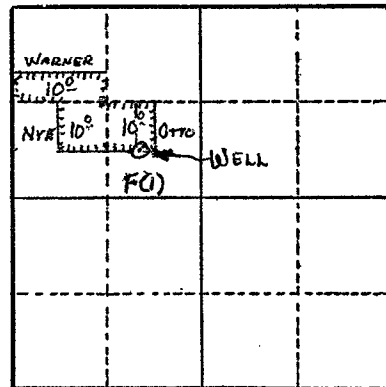

Section 26

Altitude at well 900 ft.

TYPE OF WELL: Dug & Dr'd Date Constructed 1925

Depth drilled 100 ft. Depth cased 20 ft.

CASING RECORD:

8 inch from 32 to 52 ft.

FINISH:

AQUIFERS:

WATER LEVEL:

18 to 40 ft.

PUMPING EQUIPMENT: Type 2 1/2 in. H.P. 7 1/2
Capacity 200 G.P.M.

WELL TESTS:

Drawdown 15 ft. after hours 400 G.P.M.
Drawdown ft. after hours G.P.M.

USE OF WATER Irrigation Temp. °F. 19

SOURCE OF INFORMATION G. R. Record

DRILLER or DIGGER

ADDITIONAL DATA:

Log Water Level Measurements Chemical Analysis Aquifer Test

REMARKS:

Log: Soil 0 to 8 ft.
Gravel 8 to 32 ft.
Cement gravel 32 to 40 ft.
Gravel & clay 40 to 100 ft.

Irrigation of 30 acres.