

STATE ENGINEER  
Salem, Oregon

UMAT  
4692

# Well Record


STATE WELL NO. 6N/35-26J  
COUNTY Umatilla  
APPLICATION NO. CR-3841

OWNER: Aaron Weis  
MAILING ADDRESS: Route 3, Box

LOCATION OF WELL: Owner's No.  
CITY AND STATE: Milton-Freewater, Oregon

NE 1/4 SE 1/4 Sec. 26 T. 6 N. R. 35 E. W., W.M.

Bearing and distance from section or subdivision  
corner 51' N. from a pt. 54' W. from SE Cor.  
NE 1/4 SE 1/4 Sec. 26

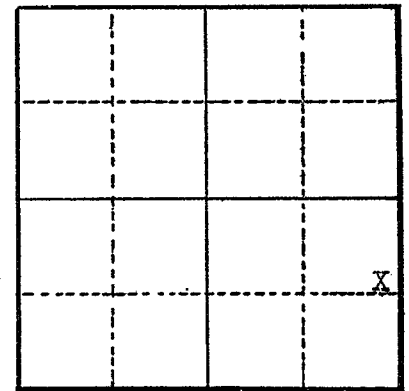

Section 26

Altitude at well

TYPE OF WELL: Dug 45 Date Constructed Feb., 1920  
Drilled 20  
Depth drilled 65 feet Depth cased 55 feet

### CASING RECORD:

8 inch casing from 45 to 55 feet

### FINISH:

### AQUIFERS:

### WATER LEVEL:

16 feet below surface

PUMPING EQUIPMENT: Type Pacific centrifugal H.P. 7 1/2  
Capacity 500 G.P.M.

### WELL TESTS:

Drawdown ft. after hours 500 G.P.M.  
Drawdown ft. after hours G.P.M.

USE OF WATER Irrigation Temp. °F., 19

SOURCE OF INFORMATION Well Registration Statement

### DRILLER or DIGGER

### ADDITIONAL DATA:

Log X Water Level Measurements Chemical Analysis Aquifer Test

### REMARKS:

Log: 2 ft. top soil, rest rocky to bottom of well Bottom 65'