

STATE ENGINEER
Salem, Oregon

UMAT
4693

Well Record


STATE WELL NO. 6N/35-26Q
COUNTY Umatilla
APPLICATION NO. GR-4072

OWNER: Stearl P. McReynolds MAILING ADDRESS: Route 3,

LOCATION OF WELL: Owner's No. CITY AND STATE: Milton-Freewater, Oregon

SW 1/4 SE 1/4 Sec. 26 T. 6 N. R. 35 E. W., W.M.

Bearing and distance from section or subdivision corner 633' E. & 495' N. of S¹/₄ Cor. Sec. 26

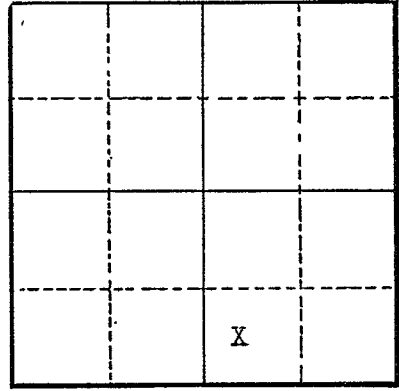

Altitude at well _____

TYPE OF WELL: Dug 40' ~~Dug 40'~~ Dug 40' Date Constructed 1920 prior

Depth drilled 70 ft. Depth cased _____

Section 26

CASING RECORD:

72 inch concrete from 0 to 10 feet
6 inch steel casing from 34' to unknown depth

FINISH:

AQUIFERS:

WATER LEVEL:

40 feet below surface

PUMPING EQUIPMENT: Type centrifugal 3" H.P. 3
Capacity 150 G.P.M.

WELL TESTS:

Drawdown _____ ft. after _____ hours _____ G.P.M.
Drawdown _____ ft. after _____ hours _____ G.P.M.

USE OF WATER Irrigation Temp. _____ °F., 19 _____

SOURCE OF INFORMATION Well Registration Statement Cert. # GR-3669

DRILLER or DIGGER Henry Schocclford

ADDITIONAL DATA:

Log _____ Water Level Measurements _____ Chemical Analysis _____ Aquifer Test _____

REMARKS: