

UMAT
4694

Well Record


STATE WELL NO. 6N/35-26J
COUNTY Union
APPLICATION NO. GR-3842

OWNER: Aaron Weis MAILING ADDRESS: Route 3, Box

LOCATION OF WELL: Owner's No. CITY AND STATE: Milton-Freewater, Oregon

NE $\frac{1}{4}$ SE $\frac{1}{4}$ Sec. 26 T. 6 N. R. 35 E. W.M.

Bearing and distance from section or subdivision corner 585' E. 12' N. from SW Cor. of NE $\frac{1}{4}$ of SE $\frac{1}{4}$ Sec. 26

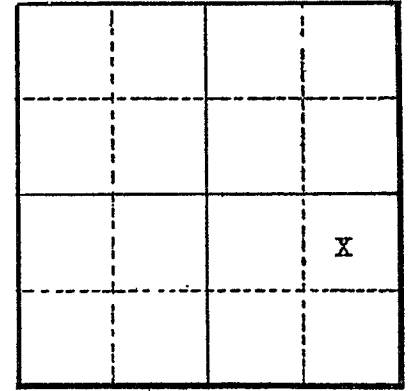

Section 26

Altitude at well

TYPE OF WELL: Dug 35' Drilled 55' Date Constructed 2/1/19

Depth drilled 90 feet Depth cased

CASING RECORD:

Dug part 5' x 5' x 16' deep
8 inch diameter drilled part (depth unknown)

FINISH:

AQUIFERS:

WATER LEVEL:

10 feet below surface

PUMPING EQUIPMENT: Type Pacific high pressure H.P. 15
Capacity 700 G.P.M.

WELL TESTS:

Drawdown _____ ft. after _____ hours _____ G.P.M.
Drawdown _____ ft. after _____ hours _____ G.P.M.

USE OF WATER Irrigation Temp. _____ °F., 19

SOURCE OF INFORMATION Well Registration Statement

DRILLER or DIGGER

ADDITIONAL DATA: Log X Water Level Measurements _____ Chemical Analysis _____ Aquifer Test _____

REMARKS:

Log: Gravel from ground surface to bottom of well Bottom 90

3500