

STATE ENGINEER
Salem, Oregon

UMAT
4695

Well Record


STATE WELL NO. 6N/35-26L
COUNTY Union
APPLICATION NO. GR-3835

OWNER: Paul Featherston MAILING ADDRESS: 22 W. B. St.

LOCATION OF WELL: Owner's No. CITY AND STATE: College Place, Washington

NE 1/4 SW 1/4 Sec. 26 T. 6 N. S, R. 35 W., W.M.

Bearing and distance from section or subdivision corner 660' S. & 1304' E. of W¹ Cor.

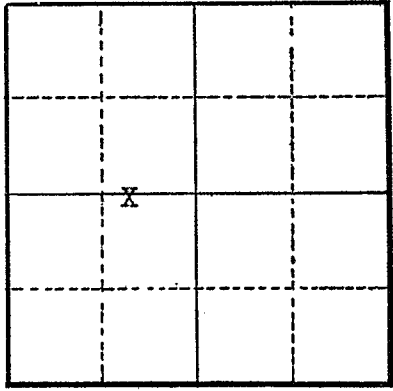

Section 26

Altitude at well _____

TYPE OF WELL: Drilled Date Constructed 1919
Depth drilled 70 feet ^{Dug 40} Depth cased 68 feet

CASING RECORD:

60 inch diameter concrete from 0 to 20 feet
8 inch diameter steel casing from 38 to 68 feet

FINISH:

1/2" x 6" - 5 around diameter from 38 to 68 feet

AQUIFERS:

WATER LEVEL:

30 feet below surface

PUMPING EQUIPMENT: Type Pacific 2" centrifugal H.P. 3
Capacity 120 G.P.M.

WELL TESTS:

Drawdown _____ ft. after _____ hours _____ G.P.M.
Drawdown _____ ft. after _____ hours _____ G.P.M.

USE OF WATER Irrigation Temp. _____ °F., 19____

SOURCE OF INFORMATION Well Registration Statement

DRILLER or DIGGER _____

ADDITIONAL DATA:
Log _____ Water Level Measurements _____ Chemical Analysis _____ Aquifer Test _____

REMARKS:

5495