

STATE ENGINEER
Salem, Oregon



Well Record

STATE WELL NO. 6N/35-26
COUNTY UMATILLA
APPLICATION NO. GR-2643

OWNER: Charles Eiffert


MAILING ADDRESS: Milton-Freewater,

LOCATION OF WELL: Owner's No. _____

CITY AND STATE: Oregon

$N\frac{1}{4}$ SE $\frac{1}{4}$ SW $\frac{1}{4}$ Sec. 26 T. 6 N. S, R. 35 E. W, W.M.

Bearing and distance from section or subdivision corner 740' N. and 100' W.

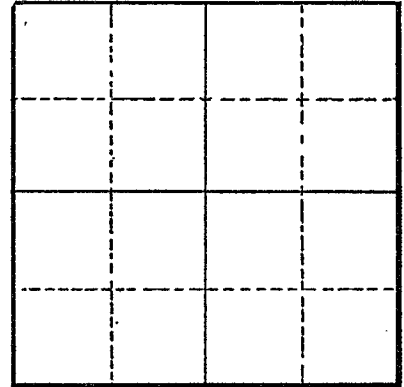

Section _____

Altitude at well _____

TYPE OF WELL: Dug & Drill Date Constructed 1918

Depth drilled 100 Depth cased _____

CASING RECORD:

FINISH:

AQUIFERS:

Rock and gravel

WATER LEVEL:

50-feet

PUMPING EQUIPMENT: Type Peerless Electric H.P. 7 $\frac{1}{2}$
Capacity 500 G.P.M.

WELL TESTS:
Drawdown 12 ft. after _____ hours Pumping 500 G.P.M.
Drawdown _____ ft. after _____ hours _____ G.P.M.

USE OF WATER Irrigation Temp. _____ °F., 19

SOURCE OF INFORMATION GR-2505

DRILLER or DIGGER _____

ADDITIONAL DATA:
Log Water Level Measurements _____ Chemical Analysis _____ Aquifer Test _____

REMARKS:

Rock and gravel