

STATE ENGINEER  
Salem, Oregon

UMAT  
4697

# Well Record

STATE WELL NO. 6N/35-26C(1)  
COUNTY Umatilla  
APPLICATION NO. GR-1147

GR- 1107

OWNER: John Starkel

MAILING

ADDRESS:

Rt. 3, Box 205

LOCATION OF WELL: Owner's No.

CITY AND


STATE:

Milton-Freewater, Oregon

NE 1/4 NW 1/4 Sec. 26 T. 6 N. R. 35 E., W.M.

Bearing and distance from section or subdivision

corner 430' S. & 228' W. from N 1/4 cor. Sec. 26.

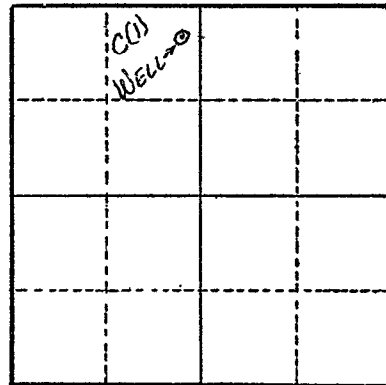

Section 26

Altitude at well 900 ft.

TYPE OF WELL: Dug & drilled Date Constructed 1916

Depth drilled 54 ft. Depth cased 50 ft.

### CASING RECORD:

- 6 ft. concrete from 0 to 16 ft.
- 8 in. steel from 20 to 54 ft.

### FINISH:

### AQUIFERS:

### WATER LEVEL:

14 ft. ( measured in March '58 )

PUMPING EQUIPMENT: Type Cent. H.P. 5  
Capacity 140 G.P.M.

### WELL TESTS:

Drawdown 8 to 10 ft. after \_\_\_\_\_ hours 140 G.P.M.

Drawdown \_\_\_\_\_ ft. after \_\_\_\_\_ hours \_\_\_\_\_ G.P.M.

USE OF WATER Irrigation Temp. \_\_\_\_\_ °F. \_\_\_\_\_, 19

SOURCE OF INFORMATION G. R. Record

DRILLER or DIGGER

### ADDITIONAL DATA:

Log N. A. Water Level Measurements \_\_\_\_\_ Chemical Analysis \_\_\_\_\_ Aquifer Test \_\_\_\_\_

### REMARKS:

Irrigation of 13.7 acres.