

STATE ENGINEER  
Salem, Oregon

UMAT  
4698

# Well Record

STATE WELL NO. 6N/35-26M(1)  
COUNTY Umatilla  
APPLICATION NO. GR-1180

GR- 1141


OWNER: Wilbur Stadelman, a partner in  
Stadelman Farm.

MAILING ADDRESS: \_\_\_\_\_

LOCATION OF WELL: Owner's No. \_\_\_\_\_

CITY AND STATE: Milton-Freewater, Oregon

N. E.  
NW 1/4 SW 1/4 Sec. 26 T. 6 R. 35, W.M.

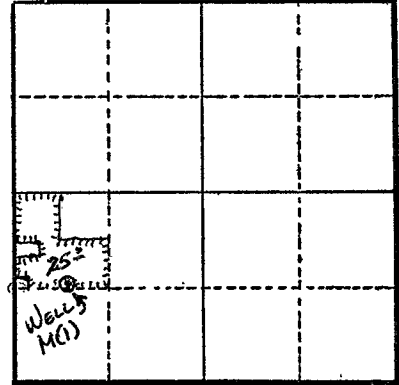

Bearing and distance from section or subdivision  
corner 742' E. & 17' N. of SW cor. of NW 1/4 SW 1/4 of  
Section 26.

Section 26

Altitude at well 850 ft.

TYPE OF WELL: Dug Date Constructed Prior to 1915

Depth drilled 45 ft. Depth cased \_\_\_\_\_

### CASING RECORD:

### FINISH:

### AQUIFERS:

### WATER LEVEL:

20 ft.

PUMPING EQUIPMENT: Type Krogh 3 x 4 in. H.P. 5  
Capacity 300-350 G.P.M.

### WELL TESTS:

Drawdown 12 ft. after \_\_\_\_\_ hours 300 G.P.M.  
Drawdown \_\_\_\_\_ ft. after \_\_\_\_\_ hours \_\_\_\_\_ G.P.M.

USE OF WATER Irrigation Temp. °F. \_\_\_\_\_, 19

SOURCE OF INFORMATION G. R. Record

DRILLER or DIGGER \_\_\_\_\_

### ADDITIONAL DATA:

Log \_\_\_\_\_ Water Level Measurements \_\_\_\_\_ Chemical Analysis \_\_\_\_\_ Aquifer Test \_\_\_\_\_

### REMARKS:

Log: Dirt & gravel from 0 to 45 ft.

Irrigation of 25 acres.