

STATE ENGINEER  
Salem, Oregon

UMAT  
4699

# Well Record


STATE WELL NO. 6N/35-26H  
COUNTY Umatilla  
APPLICATION NO. CR-4005

OWNER: Gail W. Herndow MAILING ADDRESS: Box 225, Route 3

LOCATION OF WELL: Owner's No. \_\_\_\_\_ CITY AND STATE: Milton-Freewater, Oregon

SE  $\frac{1}{4}$  NE  $\frac{1}{4}$  Sec. 26 T. 6 ~~XX~~ N. R. 35 ~~W.~~ E., W.M.

Bearing and distance from section or subdivision corner 351' W. & 94' S. of NE Cor. Sec. 26

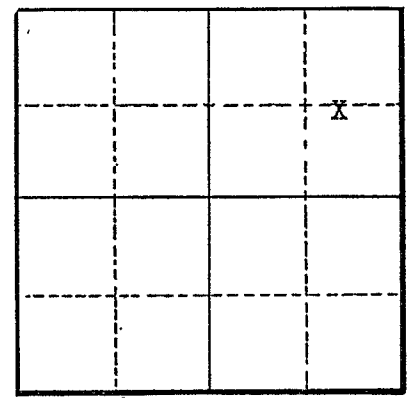

Section 26

Altitude at well \_\_\_\_\_

TYPE OF WELL: Dug & Drill Date Constructed 1913

Depth drilled 120 ft. Depth cased \_\_\_\_\_

### CASING RECORD:

72 inch diameter concrete from 0 to 15 feet  
8 inch steel casing set to unknown depth

### FINISH:

### AQUIFERS:

### WATER LEVEL:

15 feet below surface

PUMPING EQUIPMENT: Type Fairbanks Morse centrifugal 1 $\frac{1}{4}$  H.P. 3  
Capacity 100 G.P.M.

### WELL TESTS:

Drawdown \_\_\_\_\_ ft. after \_\_\_\_\_ hours \_\_\_\_\_ G.P.M.  
Drawdown \_\_\_\_\_ ft. after \_\_\_\_\_ hours \_\_\_\_\_ G.P.M.

USE OF WATER Irrigation Temp. \_\_\_\_\_ °F. \_\_\_\_\_, 19\_\_\_\_

SOURCE OF INFORMATION Well Registration Statement Cert. # CR-3612

### DRILLER or DIGGER \_\_\_\_\_

ADDITIONAL DATA:  
Log \_\_\_\_\_ Water Level Measurements \_\_\_\_\_ Chemical Analysis \_\_\_\_\_ Aquifer Test \_\_\_\_\_

### REMARKS: